

TRAFFIC CONTROL PLAN
2792J VARIOUS LOCATIONS #37
CURB RAMP WORK - VERMONT ST AT MARIPOSA ST

STREET	TIME	NORTHBOUND	SOUTHBOUND	EASTBOUND	WESTBOUND
During Curb Ramp and Sidewalk Construction					
Mariposa St. east of Vermont St.	8AM – 6PM At Other Times	-	-	1@11' Full Roadway	1@11' Full Roadway
Vermont St. at Mariposa St./US-101 Off-Ramp	Per Caltrans Encroachment Permit Requirements				
Vermont St. south of Mariposa St. & at 15 th and Division Sts.	8AM – 6PM At Other Times	1@11' Full Roadway	1@11' Full Roadway	-	-
Vermont St. between 16 th and Mariposa Streets	9AM – 3PM (M-F) 8AM – 6PM (S/S) At Other Times	2@11' 2@11' Full Roadway	-	-	-
Division St.	8AM – 6PM At Other Times	-	-	1@12' Full Roadway	Full Roadway
15 th , 18 th , 19 th and 20 th Streets	8AM – 6PM At Other Times	-	-	1@11' Full Roadway	1@11' Full Roadway
18 th St. at Connecticut St.	9AM – 4PM (M-F) 8AM – 6PM (S/S) At Other Times	-	-	1@12' Full Roadway	1@12' Full Roadway
Kansas, Arkansas, Connecticut.	8AM – 6PM At Other Times	1@12' Full Roadway	1@12' Full Roadway	-	-

WORKING HOURS

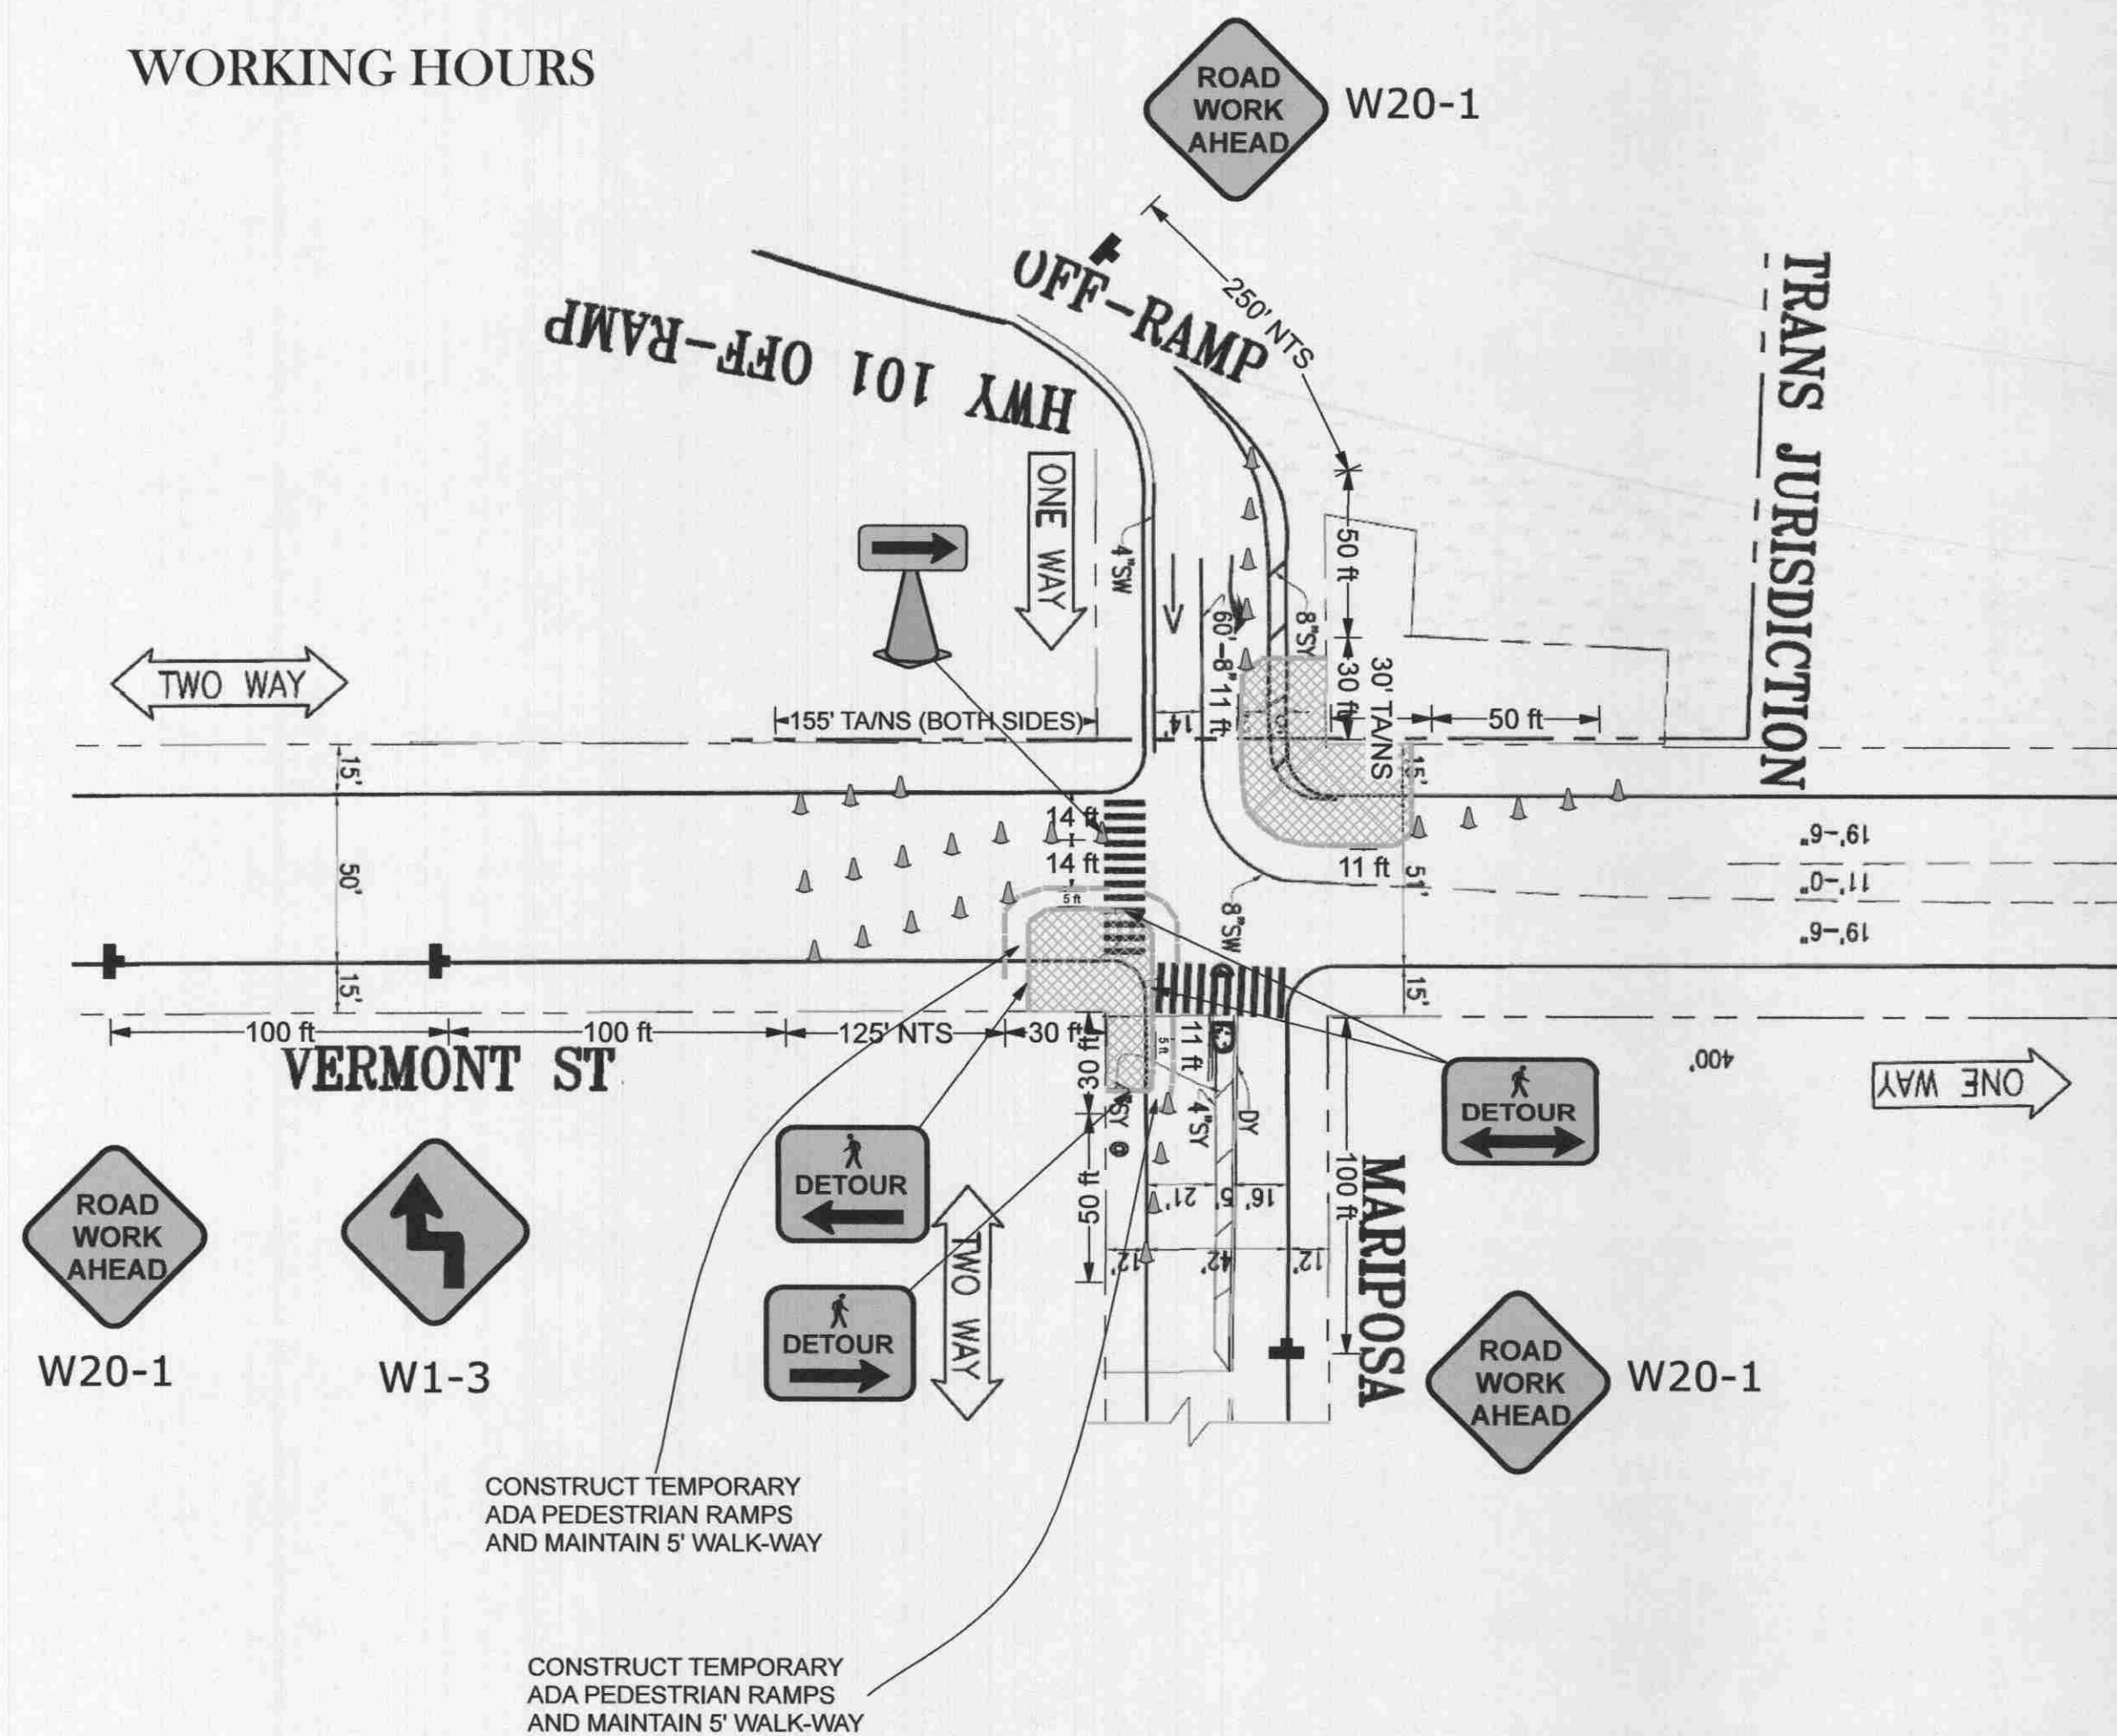


Table 6C-3(CA). Taper Length Criteria for Temporary Traffic Control Zones
(for 12 feet Offset Width)

Speed* S (mph)	Minimum Taper Length** for Width of Offset 12 feet (W)				Down Stream (feet)***
	Merging L/2 (feet)	Shifting L/2 (feet)	Shoulder L/3 (feet)	Down Stream (feet)	
20	80	40	27	50	
25	125	63	42	50	
30	160	80	60	50	
35	245	123	82	50	
40	320	160	107	50	
45	440	220	140	50	
50	600	300	200	50	
55	660	330	220	50	
60	720	360	240	50	
65	780	390	260	50	
70	840	420	280	50	

* - Posted speed limit, off-peak 65th-percentile speed prior to work starting, or the anticipated operating speed in mph.

** - For other offsets use the following merging taper length formula for L:
 For speeds of 40 mph or less, L=WS²/60
 For speeds of 45 mph or more, L=WS²/90


Where:
 L = taper length in feet
 W = width of offset in feet
 S = posted speed limit, off-peak 65th-percentile speed prior to work starting, or the anticipated operating speed in mph
 *** - Maximum downstream taper length is 100 feet. See Section 6C.08.

Table 6F-101(CA). Maximum Spacing of Channelizing Devices

Speed (mph)	Taper* (feet)	Tangent (feet)	Conflict* (feet)
20	20	40	10
25	25	50	12
30	30	60	15
35	35	70	17
40	40	80	20
45	45	90	22
50	50	100	25
55	55	110	27
60	60	120	30
65	65	130	32
70	70	140	35

* Maximum channelizing device spacing for all speeds on one-lane/two-way tapers is 20 feet.
 Maximum channelizing device spacing for all speeds on downstream tapers is 20 feet.
 All other tapers are as shown.

** Use on intermediate and short-term projects for taper and tangent sections where there are no pavement markings or where there is a conflict between existing pavement markings and channelizers (CA)

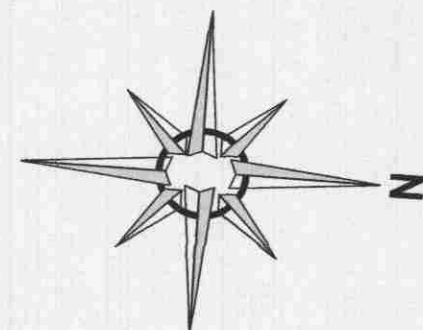

Plan Scale

1" = 50'

Table 6C-1. Recommended Advance Warning Sign Minimum Spacing

Road Type	Distance Between Signs*		
	A	B	C
Urban (low speed) - 25 mph or less	100 feet	100 feet	100 feet
Urban (high speed) - more than 25 mph to 40 mph	200 feet	200 feet	200 feet
Urban (high speed) - more than 40 mph	350 feet	350 feet	350 feet
Rural	500 feet	500 feet	500 feet
Expressway / Freeway	1,000 feet	1,500 feet	2,000 feet

* The column headings A, B, and C are the dimensions shown in Figures 6H-1 through 6H-48. The A dimension is the distance from the transition or point of restriction to the first sign. The B dimension is the distance between the first and second signs. The C dimension is the distance between the second and third signs. (The "first sign" is the sign in a three-sign series that is closest to the TTC zone. The "third sign" is the sign that is furthest upstream from the TTC zone.)



Legend

- Channelizer
- 28" Traffic Cone
- Work Area
- Sign and Stand
- Type III Barricade (Plain View)
- ADA Pedestrian Barricades
- NTS Not To Scale
- TA/NS Tow-Away/No Stopping
- Crash Cushion
- Flagger
- Water Filled Barrier



3450 3RD ST #3C
 SAN FRANCISCO, CA 94124
 415-206-1700 PHONE
 415-206-1711 FAX
 INFO@CMCTRAFFIC.COM

LICENSE NO 792059
 CLASS A, 31, C21
 WBE/SBE/LBE/DBE CERTIFIED
 WWW.CMCTRAFFIC.COM

Date: 1/17/2019 Author: KR/DD Project: 2792J
 Client: PRECISION Owner: SFDPW Location: SAN FRANCISCO
 TCP: 049 Job #: 1812 Rev: 0

Comments:

- 1) WORK HOURS: 8AM - 6PM
- 2) CONTRACTOR TO VERIFY EXISTING STRIPING IS ACCURATE PRIOR TO START OF WORK.
- 3) ALL TRAFFIC CONTROL SHALL CONFORM TO THE LATEST EDITION OF CA MUTCD.
- 4) ALL TRAFFIC CONTROL DEVICES SHALL BE RETROREFLECTIVE IF SETUP DURING HOURS OF DARKNESS.
- 5) THE CONTRACTOR SHALL BE ALLOWED TO WORK AT A MAXIMUM OF THREE INTERSECTIONS AT ANY TIME IF THERE ARE MULTIPLE CURB RAMPS TO BE CONSTRUCTED ALONG A STREET, EXCEPT AS OTHERWISE NOTED IN SPECIFICATIONS.
- 6) NO CROSSWALK SHALL BE ALLOWED TO BE CLOSED DURING CURB RAMP WORK EXCEPT DURING DEMOLITION OF CURB RAMPS IN WHICH CONTRACTOR MAY CLOSE ONLY ONE CROSSWALK AT A TIME AND PROVIDE TWO FLAGGERS TO GUIDE PEDESTRIANS TO THE OPEN CROSSWALK.
- 7) MAINTAIN LOCAL ACCESS TO BUSINESSES AND RESIDENTS AT ALL TIME.

NO EXCEPTIONS TAKEN
 MAKE CORRECTIONS NOTED
 REVISIONS
 REVISE AND REEVALUATE
 SUBMIT SPECIFIED ITEM(S)

Reviewed for general performance
 with no concern of the project and
 general compliance with the requirements
 of the contract documents. Any action
 shown is subject to the requirements of the
 contract documents. Contractors
 to actual dimensions when not noted
 confirmed fabrication processes and
 techniques of construction, coordination of
 the contractor's work with that of all other
 trades and the satisfactory performance of
 the contractor's work.

Sustainable Streets Division
 San Francisco Municipal Transportation Agency
 City and County of San Francisco

By: KCV LS05 Date: 2/26/19