



NOTES:

1. TOPOGRAPHIC SURVEY PERFORMED BY TELAMON ENGINEERING CONSULTANTS, INC. IN MAY 2015 USING AN ASSUMED HORIZONTAL AND VERTICAL DATUM, SEE REFERENCE POINT ON TOP OF LPFH.
2. PROPERTY LINE IS APPROXIMATE AND BASED ON THE LATEST GRADE MAP INFORMATION OBTAINED FROM THE CITY & COUNTY OF SAN FRANCISCO DEPARTMENT OF PUBLIC WORKS (SFPDW) WEBSITE: "HTTP://BSM.SFPDW.ORG/SUBDIVISION/KEYMAP/".
3. FACE OF CURB RADIUS AS NOTED.
4. ADJUST CATCH BASIN AND GRATE TO NEW CURB ALIGNMENT.
5. CONTACT BUREAU OF STREET USE AND MAPPING TO COORDINATE MODIFICATION OF MONUMENT PRIOR TO CONSTRUCTION.



PRECISION
ENGINEERING
1939 NEWCOMB AVENUE
SAN FRANCISCO, CA 94124

AS BUILT
DRAWINGS
Sign *[Signature]*

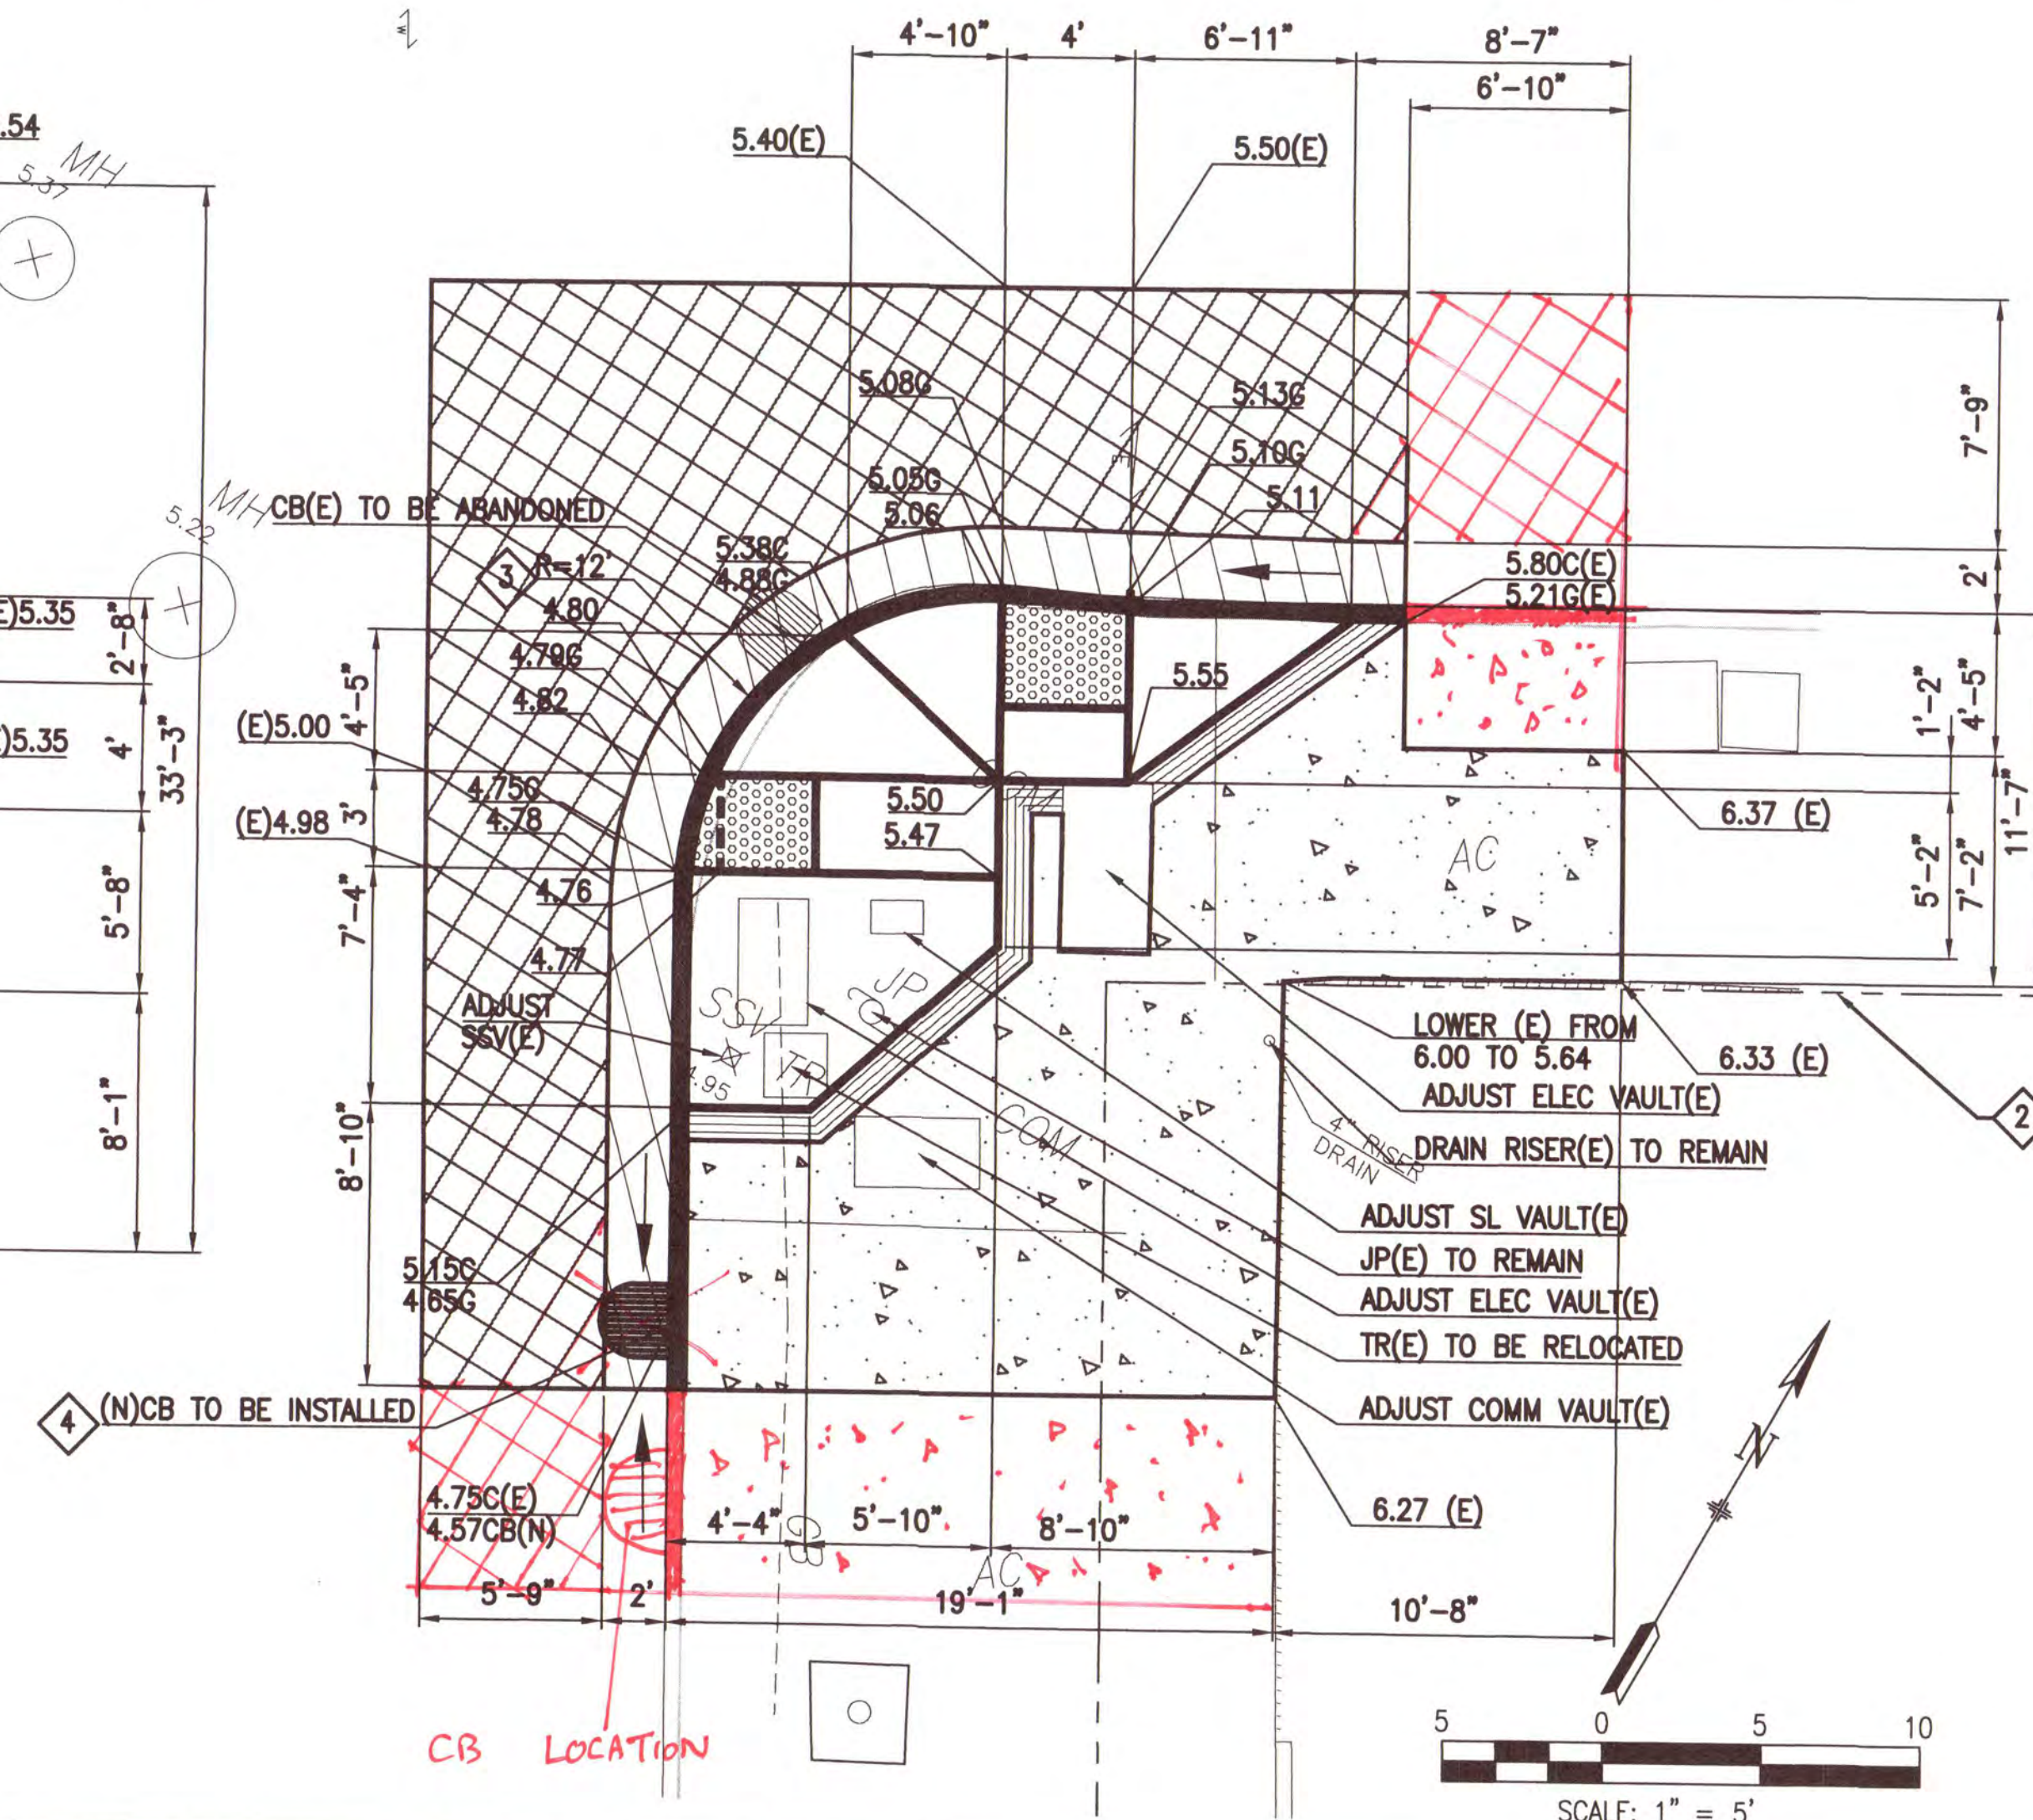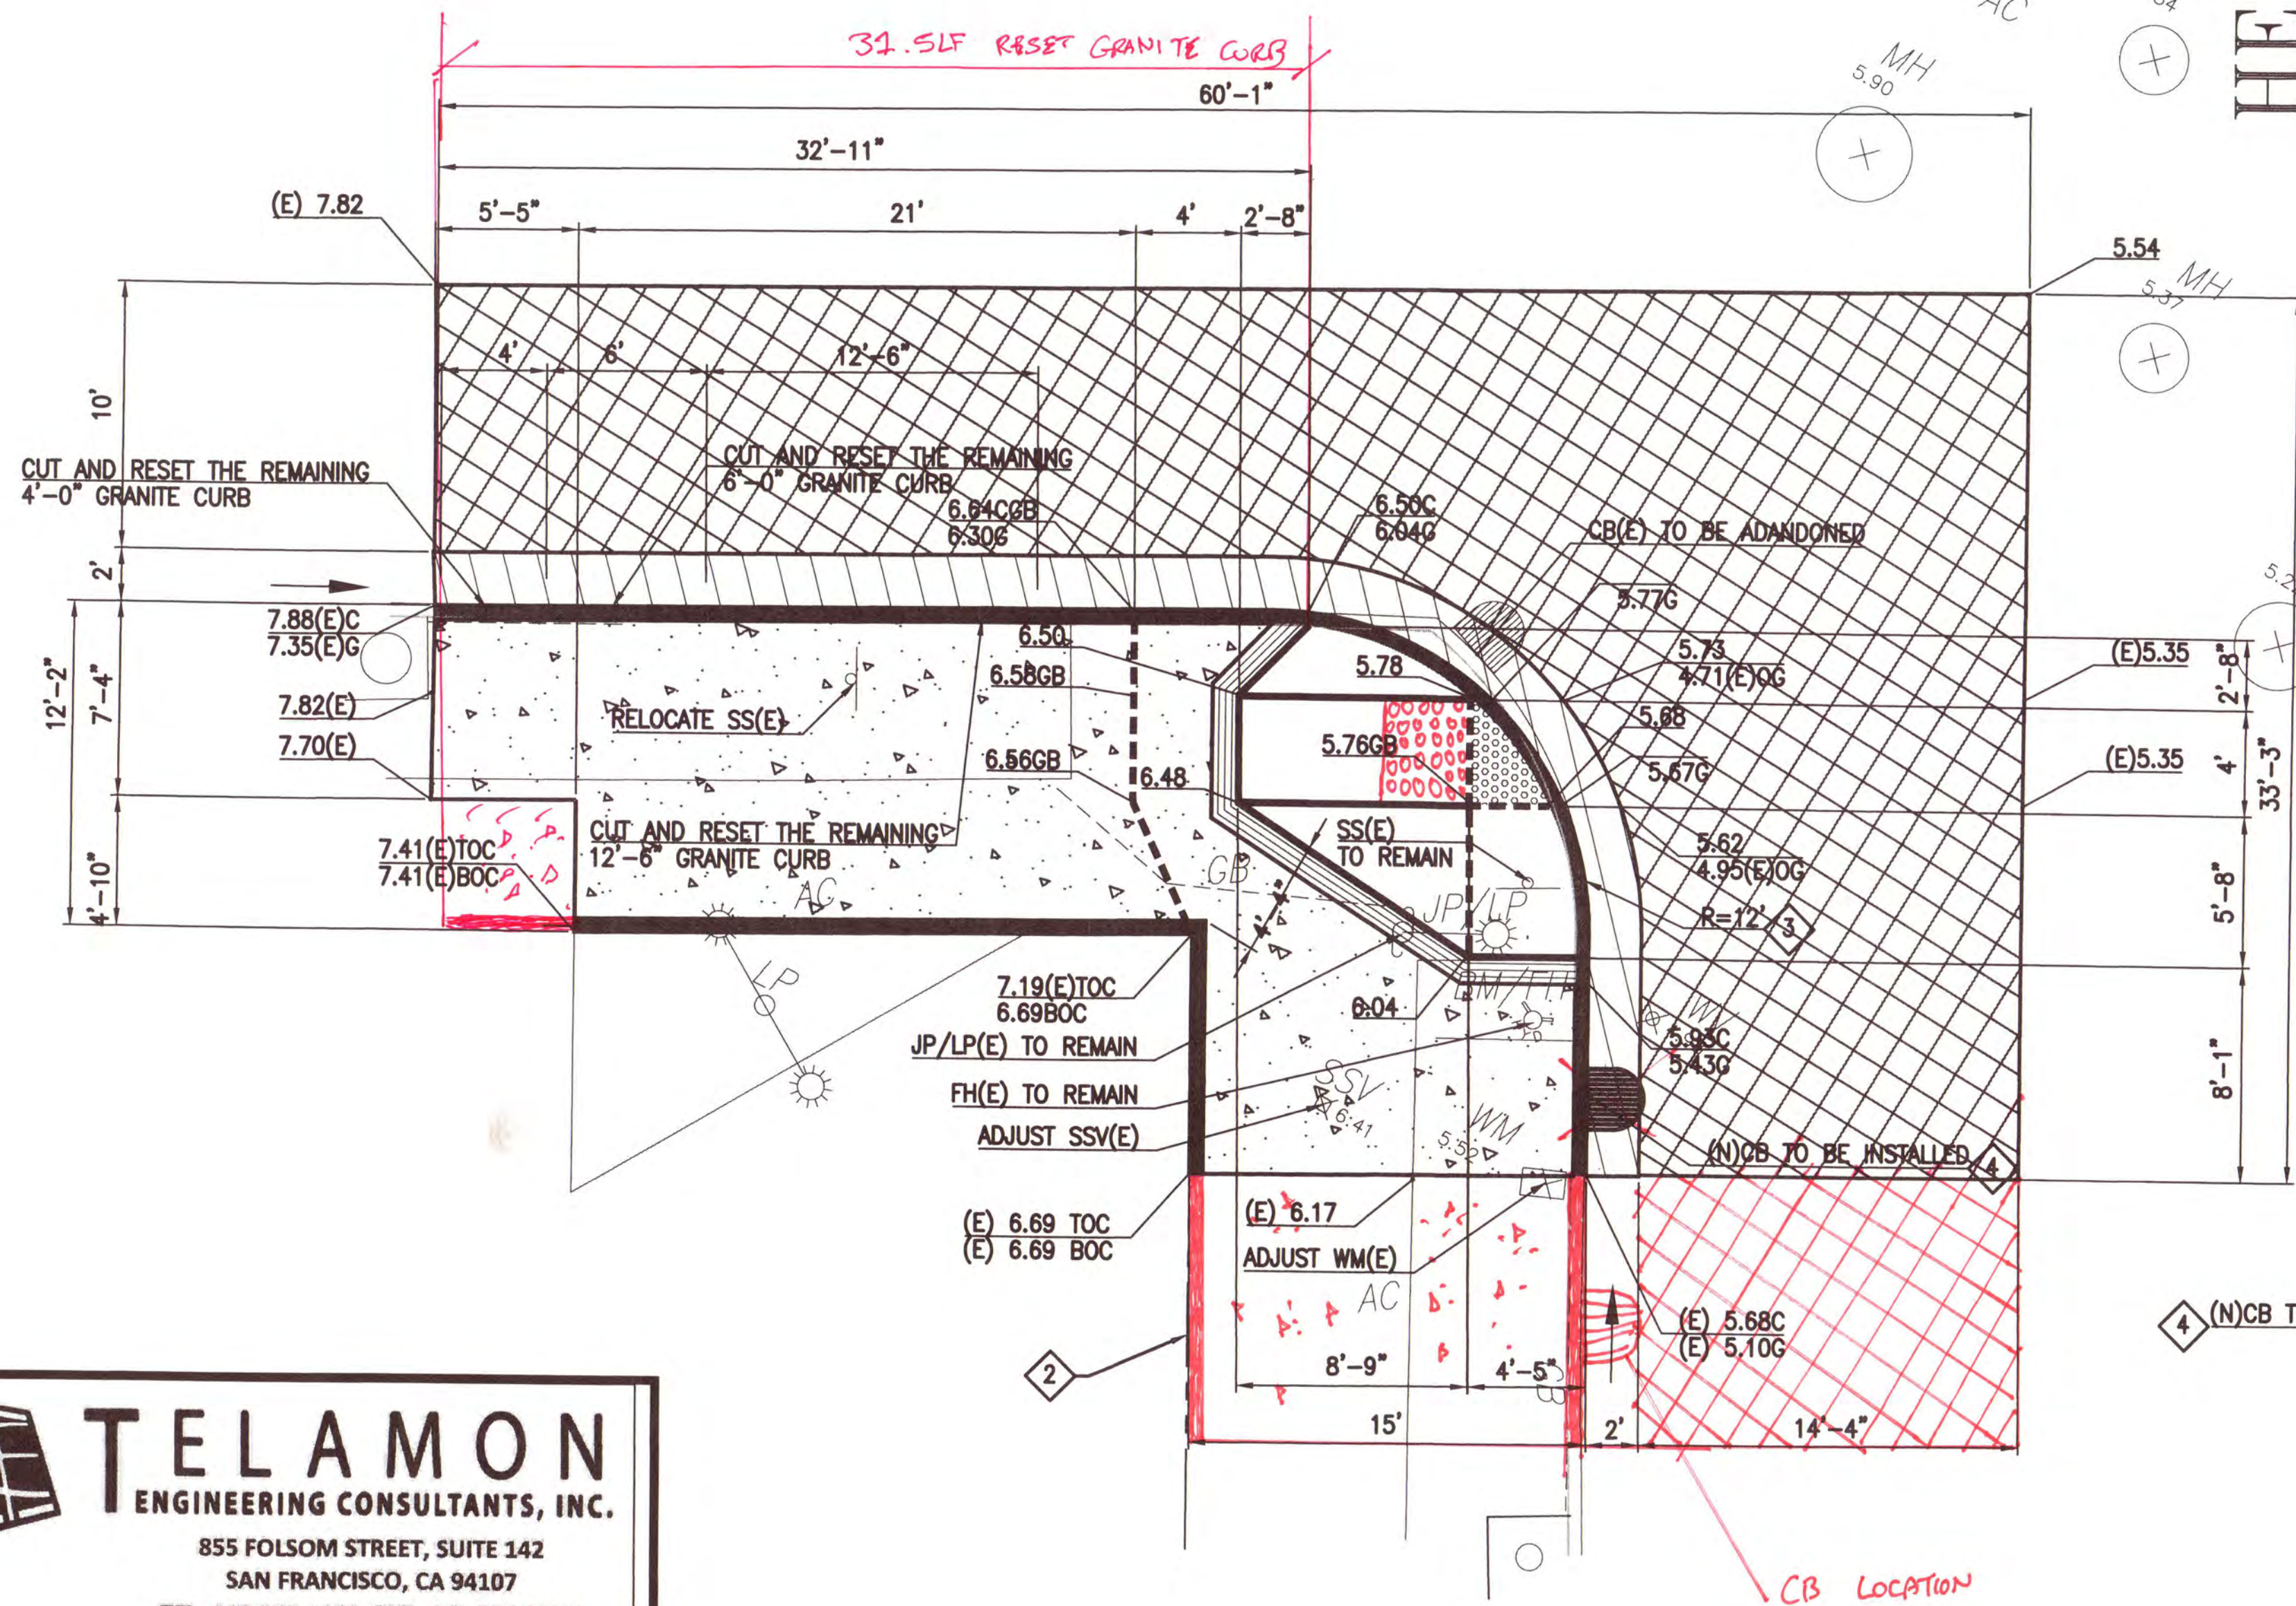

TELAMON
ENGINEERING CONSULTANTS, INC.
855 FOLSOM STREET, SUITE 142
SAN FRANCISCO, CA 94107
TEL: 415-837-1336 FAX: 415-837-1354

REFERENCE INFORMATION
& FILE NO. OF SURVEYS



DESIGN & ENGINEERING
PUBLIC WORKS
CITY & COUNTY OF SAN FRANCISCO
30 VAN NESS AVENUE, 5TH FLOOR
SAN FRANCISCO, CA 94102 - 6028

Section Mgr: *Eric T. Kibling* 5/16/18
Deputy Division Mgr: FERNANDO CISNEROS 5/16/18
Division Mgr: PATRICK RIVERA 5/16/18

DESIGNED: DATE: 04/18
DRAWN: DATE: 04/18
CHECKED: DATE: 04/18
MC



SCALE:
1" = 5'
SHEET OF SHEETS
41 OF 89

VARIOUS LOCATIONS
RENOVATION NO. 37 AND SEWER REPLACEMENT
ALAMEDA STREET & HENRY ADAMS STREET
CURB RAMP DETAILS

EHY JO NO. 2963J
CONTRACT NO. 2792J
DRAWING NO. CR-17
FILE NO. 109.979
REV. NO.

Drawing Path: P:\16014 CRD 2792J.VL Trk Rem\3.Dwg
Plot Time: Wed, 25 Apr 2018 2:24pm