
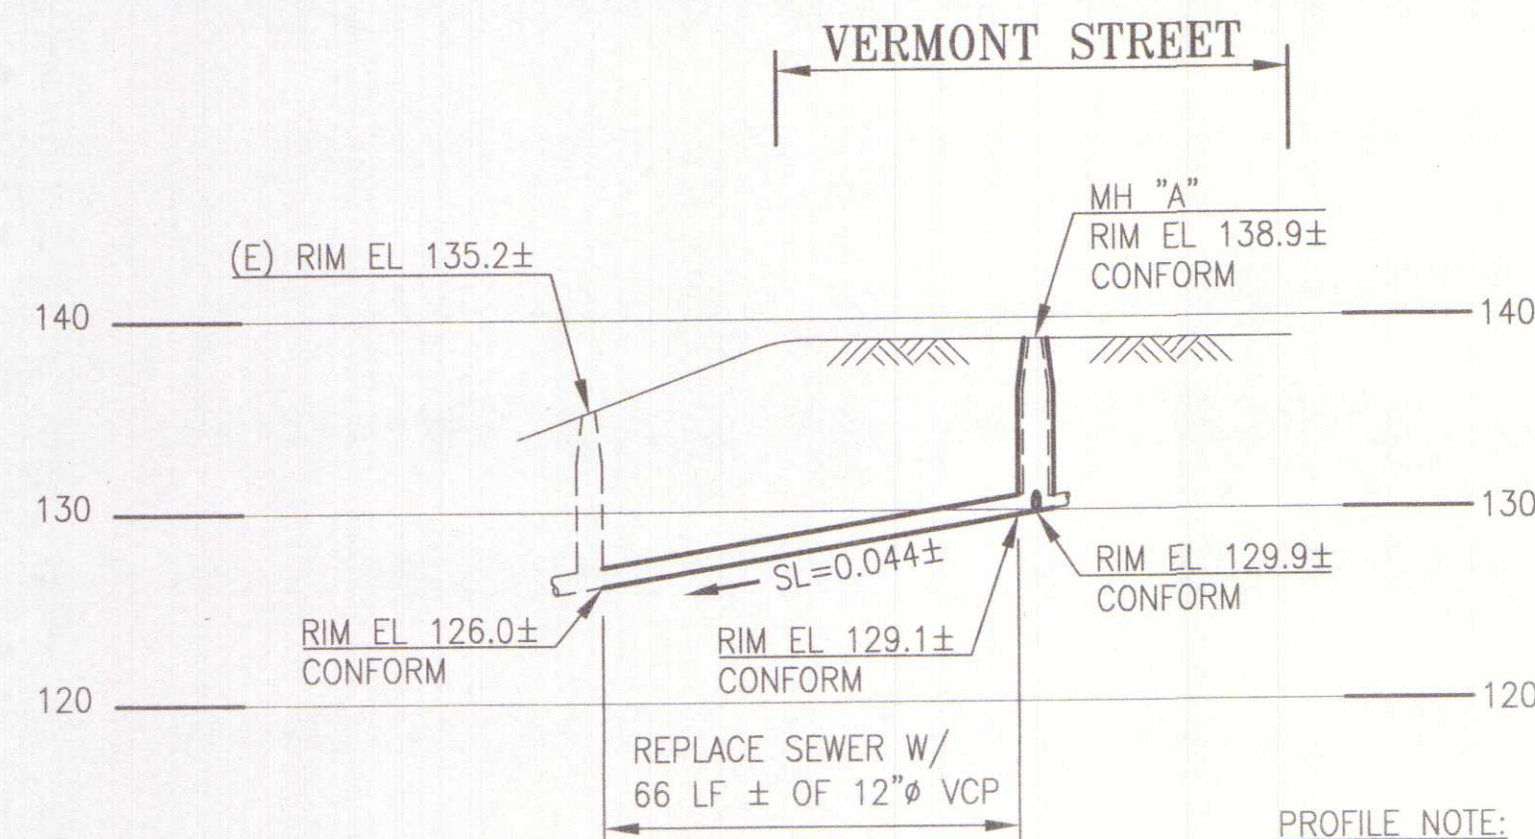



PRECISION
ENGINEERING
1939 NEWCOMB AVENUE
SAN FRANCISCO, CA 94124

AS BUILT
DRAWINGS
Sign *[Signature]*

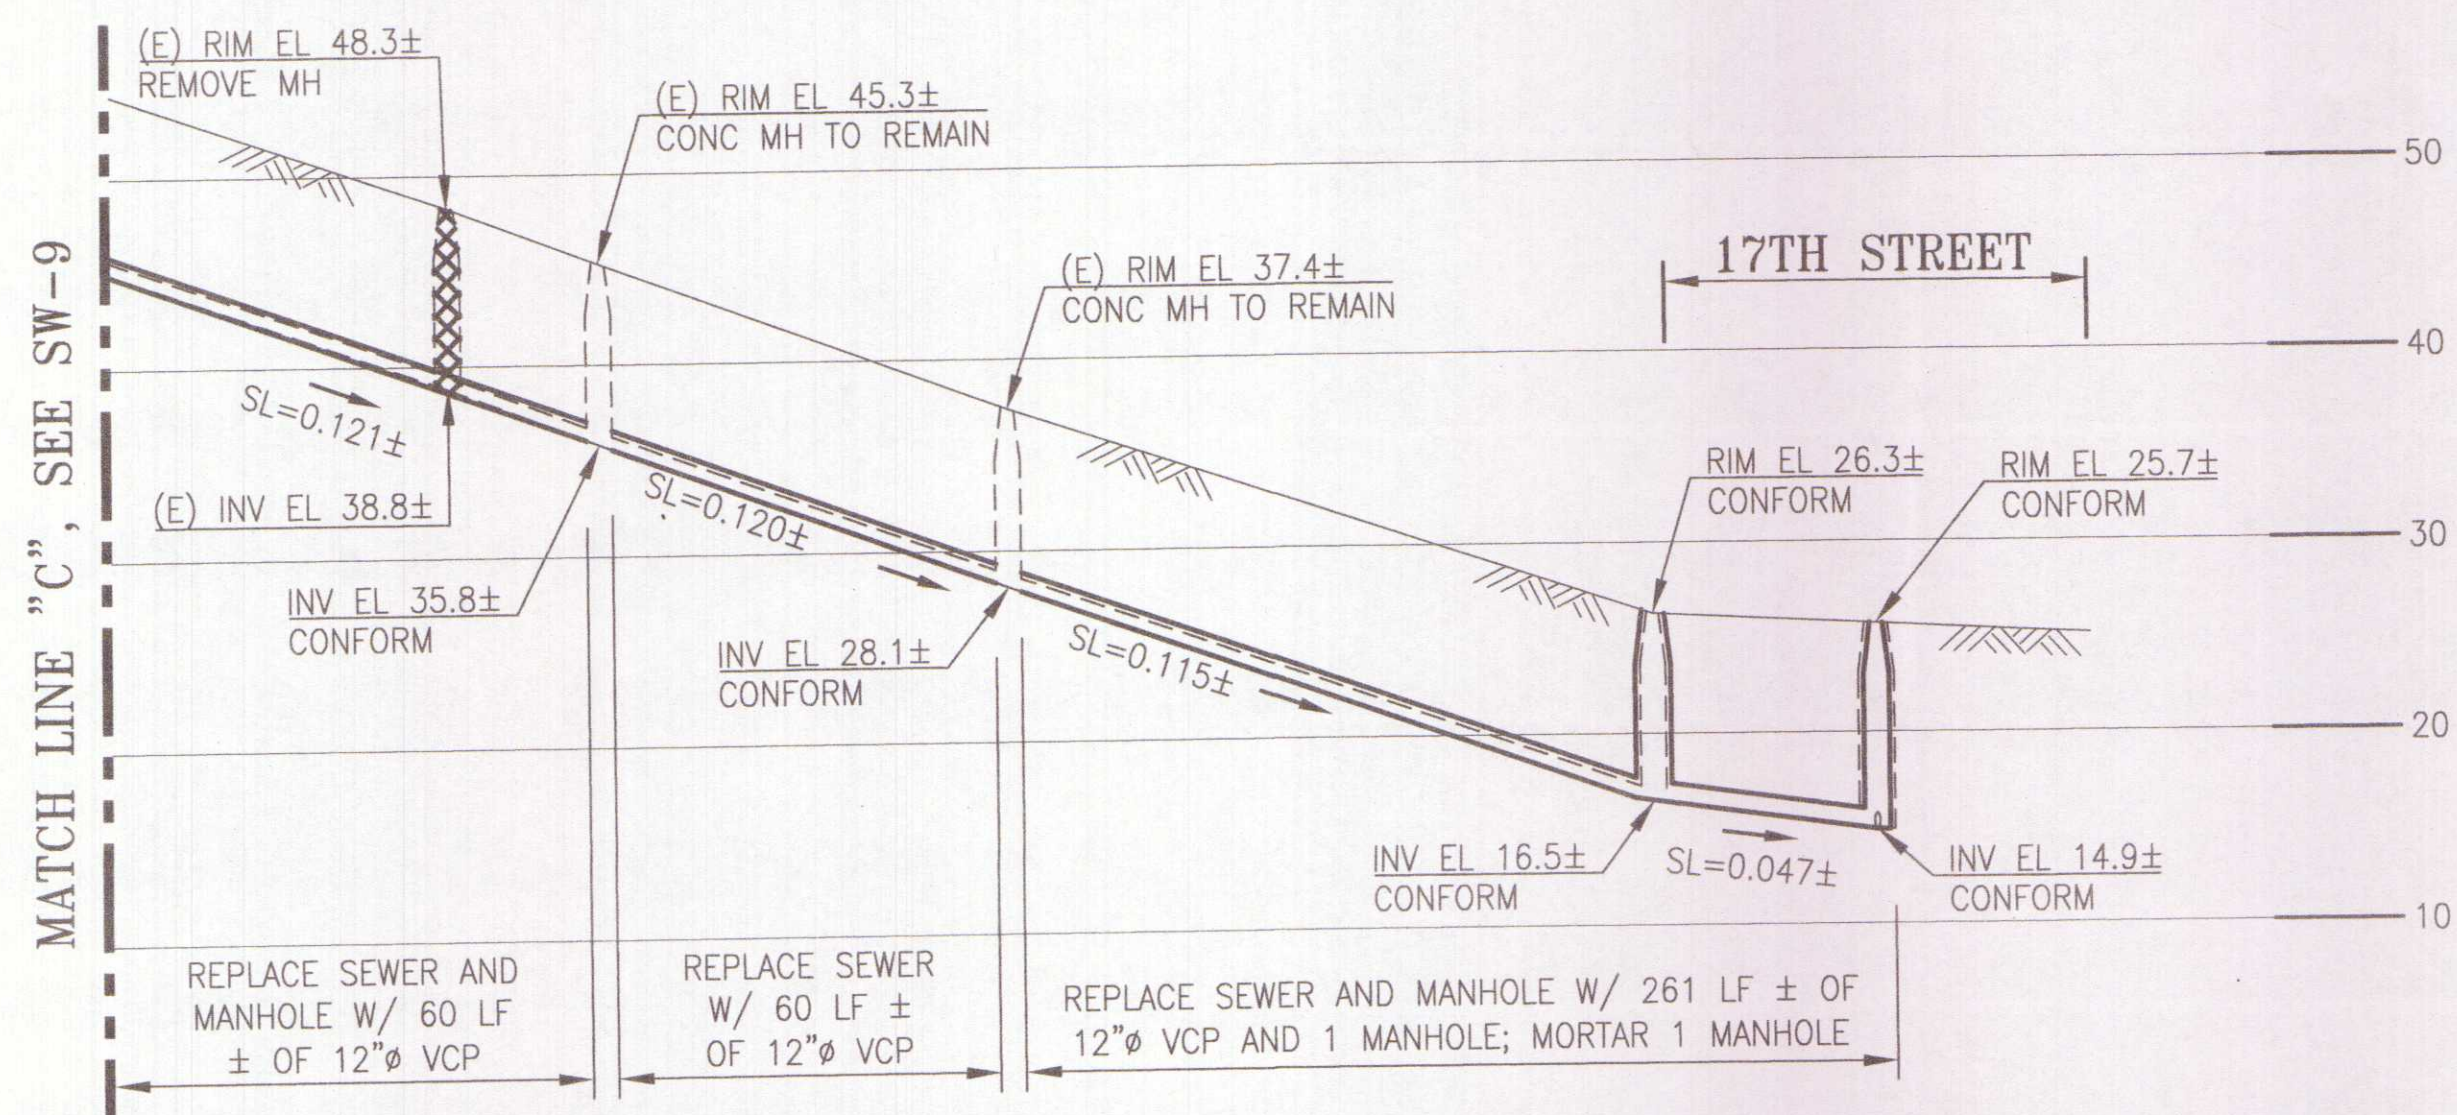

PROFILE "B"
(LOOKING NORTH AT 18TH ST AND VERMONT ST)


SCALE: HORIZ 1"=30'
VERT 1"=10'

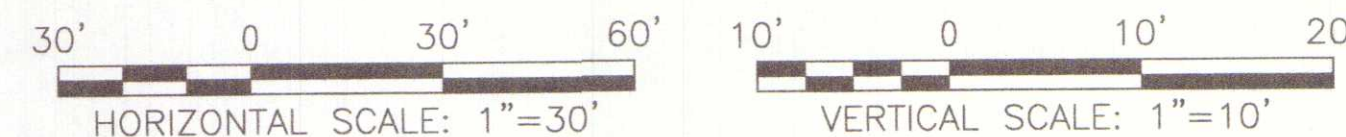

SEWER SIZED BY
Y.W. Yw

APPROVED BY
B.S. SS

REFERENCE INFORMATION
& FILE NO. OF SURVEYS
BK-074A_PG-026
BK-074A_PG-027
BK-074A_PG-028

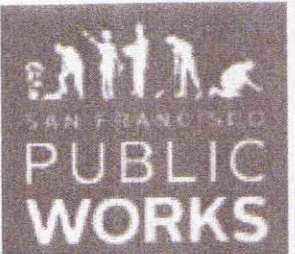

DESIGN &
ENGINEERING
CITY & COUNTY OF SAN FRANCISCO
SAN FRANCISCO PUBLIC WORKS
30 VAN NESS AVENUE, 5TH FLOOR
SAN FRANCISCO, CA 94102 - 6028

Section Mgr: *[Signature]* LESLEY WONG 4/25/18
Deputy Bureau Mgr: *[Signature]* IQBAL DHAPA 4/27/18
Bureau Mgr: *[Signature]* PATRICK RIVERA 4/27/18

DESIGNED: DATE: J.KUNG 4/2018
DRAWN: DATE: S.HUEY 4/2018
CHECKED: DATE: J.HELMUTH 4/2018



SCALE:
AS NOTED
SHEET OF SHEETS
60 OF 89

VARIOUS LOCATIONS PAVEMENT
RENOVATION NO. 37 AND SEWER REPLACEMENT
KANSAS STREET SEWER REPLACEMENT
MATCH LINE "C" TO 17TH STREET
PLAN AND PROFILES

CONTRACT NO.
2792J
DRAWING NO.
SW-10
FILE NO.
109,998
REV. NO.
0