


AS BUILT  
DRAWINGS  
Sign *[Signature]*

PRECISION  
ENGINEERING  
1939 NEWCOMB AVENUE  
SAN FRANCISCO, CA 94124

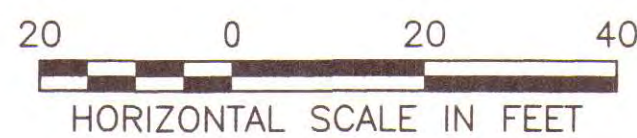

NO.	DATE	DESCRIPTION	BY	APP.

THIS DRAWING WAS LAST MODIFIED: 04/26/18 09:03, BY: LLouie


REFERENCE INFORMATION  
& FILE NO. OF SURVEYS



**DESIGN & ENGINEERING**  
CITY & COUNTY OF SAN FRANCISCO  
SAN FRANCISCO PUBLIC WORKS  
30 VAN NESS AVENUE, 5TH FLOOR  
SAN FRANCISCO, CA 94102 - 6028

Section Mgr: *[Signature]* Date: 5/16/18  
Deputy Division Mgr: *[Signature]* FERNANDO CISNEROS 5/16/18  
Division Mgr: *[Signature]* PATRICK RIVERA 5/16/18

DESIGNED: *[Signature]* DATE: 02/18  
DRAWN: *[Signature]* DATE: 02/18  
CHECKED: *[Signature]* DATE: 03/18  
D.CALLEROS

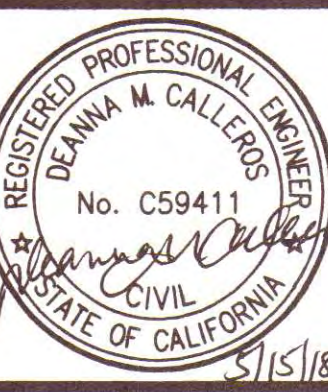

SCALE:  
1" = 20'  
SHEET OF SHEETS  
14 OF 89

VARIOUS LOCATIONS PAVEMENT  
RENOVATION NO. 37 AND SEWER REPLACEMENT  
PAVEMENT PLAN  
ALAMEDA ST - HENRY ADAMS ST/KANSAS ST TO RHODE ISLAND ST  
KANSAS ST - ALAMEDA ST TO 15TH ST

CONTRACT NO.  
2792J  
DRAWING NO.  
R-9  
FILE NO.  
109,953  
REV. NO.

Xrefs: V:\29633\_Various\_Locations\_Sewer\_Replacement-IV\_with\_VL\_PR\_No.37\Official\_Project\_TBs\DE\_TB\_22x34.dwg  
V:\29633\_Various\_Locations\_Sewer\_Replacement-IV\_with\_VL\_PR\_No.37\2\_Design\_Working\_Drawings\EHY\29633\_SW1\_18th - Arkansas  
V:\29633\_Various\_Locations\_Sewer\_Replacement-IV\_with\_VL\_PR\_No.37\2\_Design\_Working\_Drawings\EHY\29633\_SW4\_Connecticut - 16th  
V:\29633\_Various\_Locations\_Sewer\_Replacement-IV with VL PR No.37\2\_Design\_Working\_Drawings\EHY\29633\_SW5\_Connecticut - 10th  
Drawing Path: V:\2792J\_Various\_Locations\_No.37\_Pavement\_Renovation\2\_Design\_Working\_Drawings\ESH\Current\2792J\_Pavement\_Renovation.dwg  
Plot Time: Thu, 26 Apr 2018 - 9:07am  
Model Units: Feet  
Login: LLouie