



A B C D E F G H I J K L M N O P

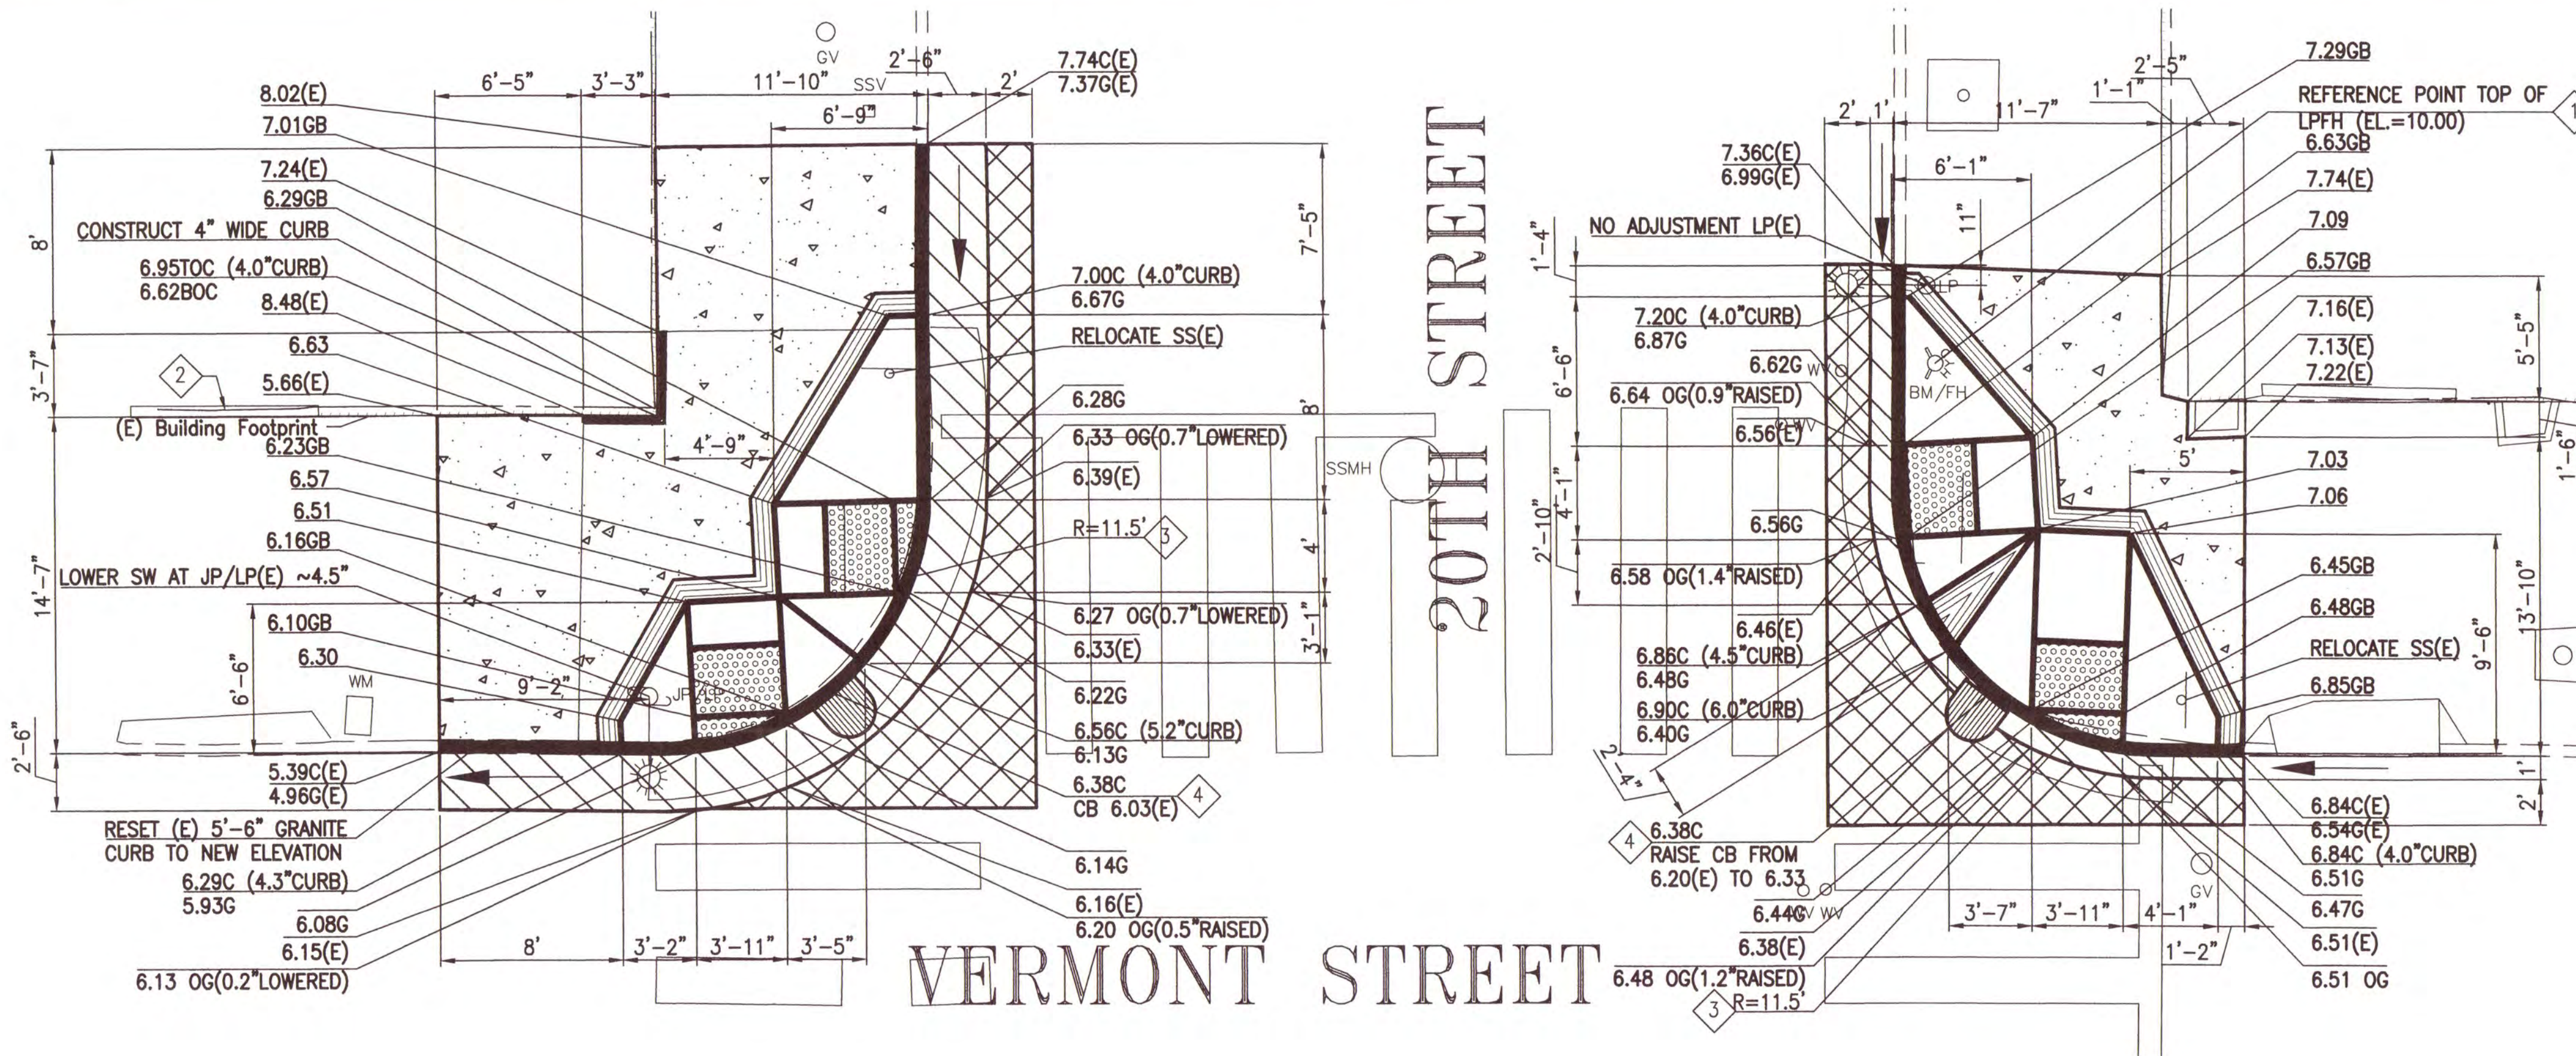

NOTES:

1. TOPOGRAPHIC SURVEY PERFORMED BY TELAMON ENGINEERING CONSULTANTS, INC. IN NOVEMBER, 2016 USING AN ASSUMED HORIZONTAL AND VERTICAL DATUM, SEE REFERENCE POINT ON TOP OF LPFH (EL=10.00).
2. PROPERTY LINE IS APPROXIMATE AND BASED ON THE LATEST GRADE MAP INFORMATION OBTAINED FROM THE CITY & COUNTY OF SAN FRANCISCO DEPARTMENT OF PUBLIC WORKS (SFPDW) WEBSITE: "HTTP://BSM.SFPDW.ORG/SUBDIVISION/KEYMAP/".
3. FACE OF CURB RADIUS AS NOTED.
4. ADJUST CB GRATE HORIZONTALLY TO NEW CURB ALIGNMENT.

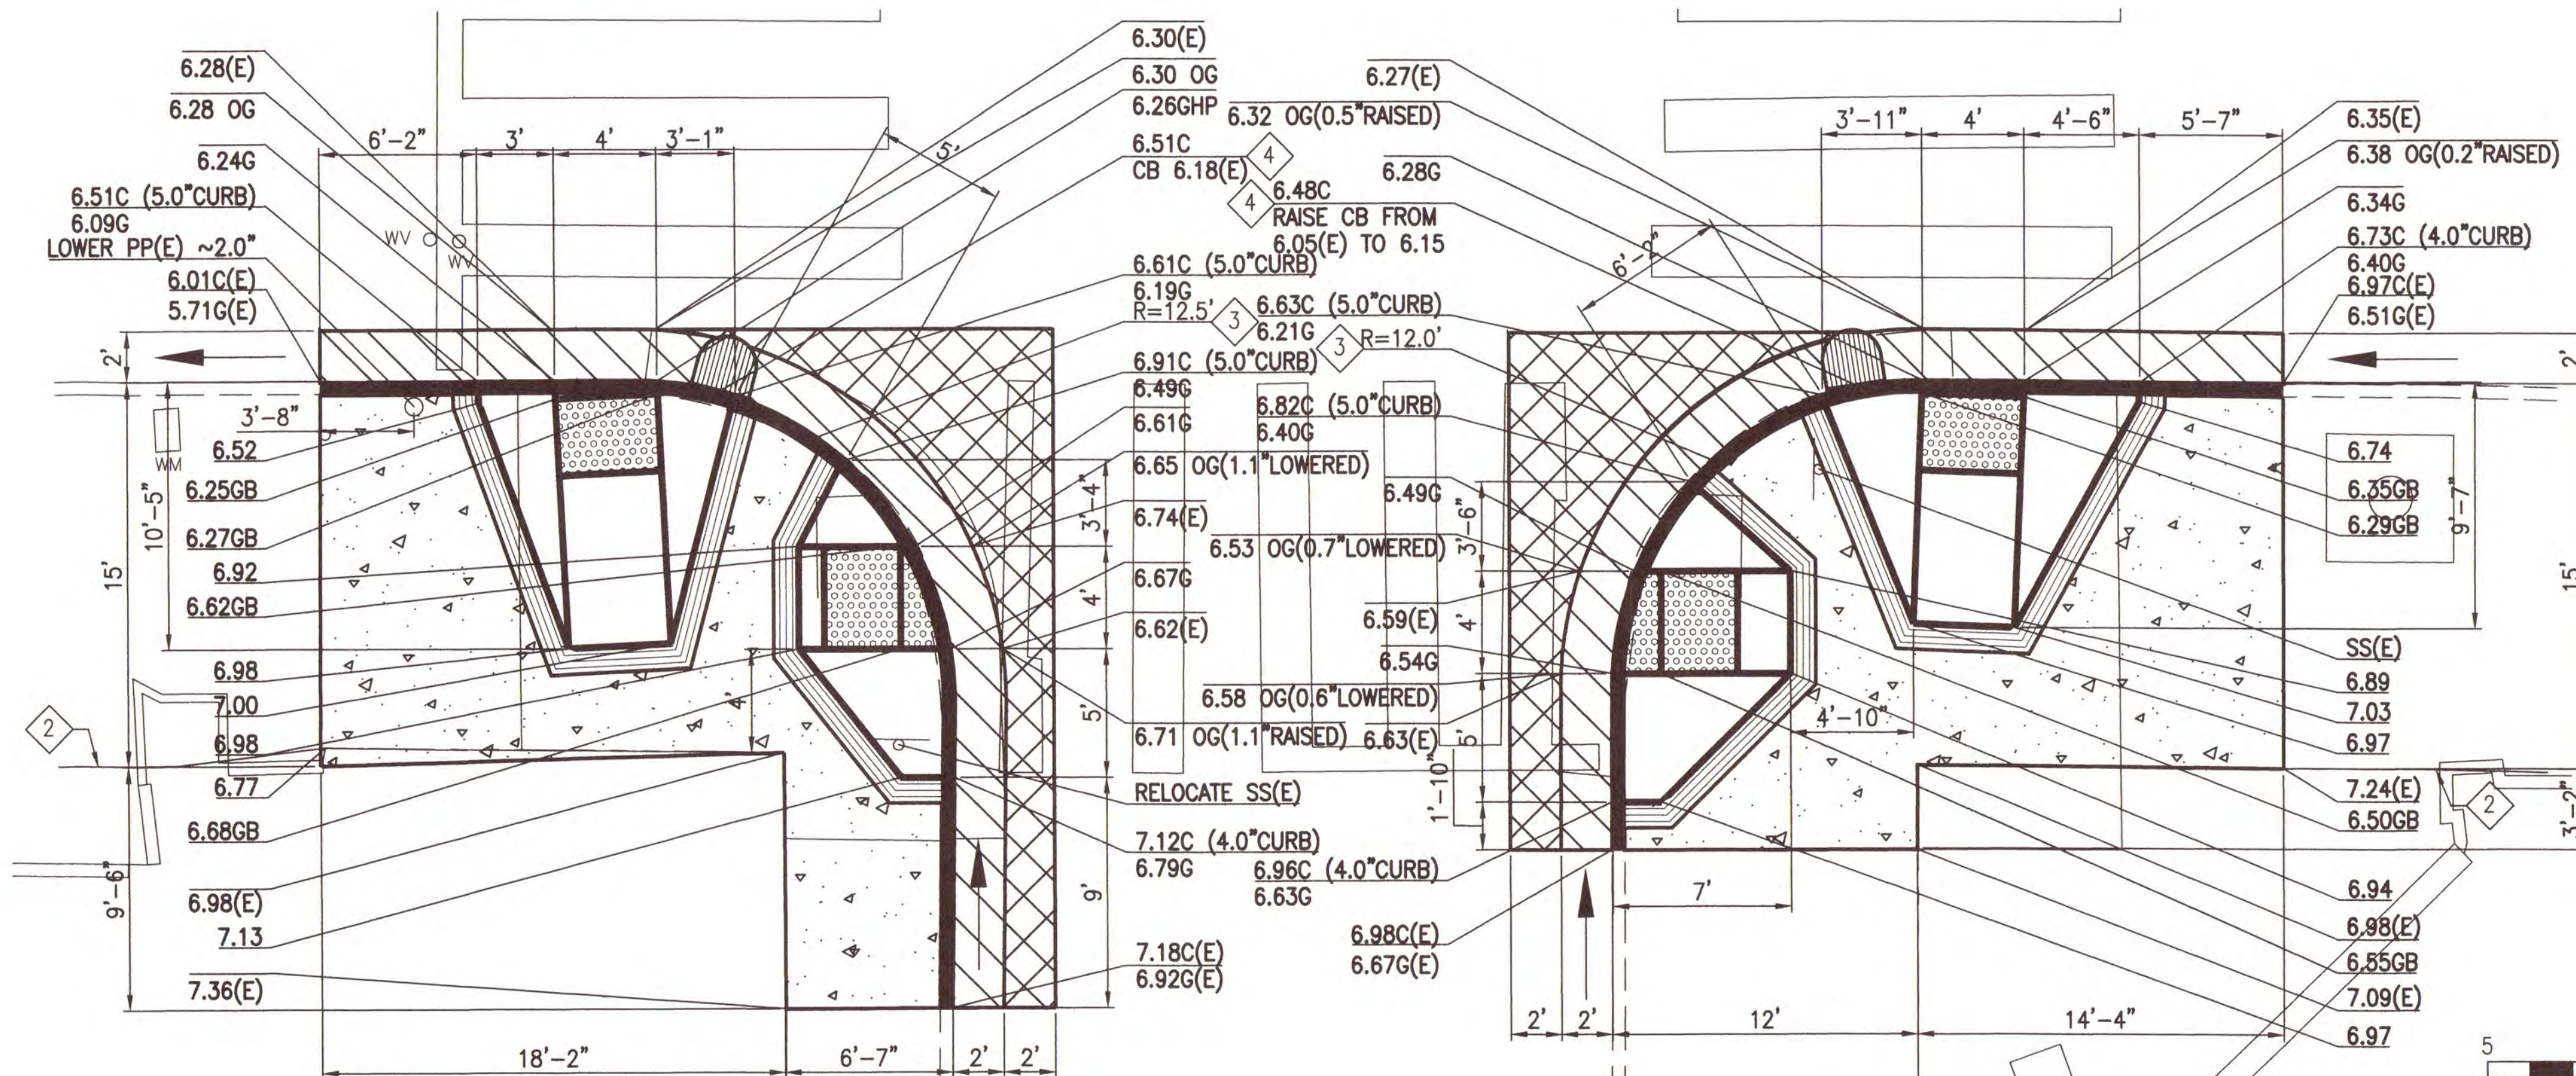

PRECISION
ENGINEERING
1939 NEWCOMB AVENUE
SAN FRANCISCO, CA 94124

AS BUILT
DRAWINGS
Sign *[Signature]*


AECOM
300 California Street, Suite 600
San Francisco, Ca 94104
Tel: 415-796-8100
Fax: 415-796-8200



DESIGN &
ENGINEERING
CITY & COUNTY OF SAN FRANCISCO
SAN FRANCISCO PUBLIC WORKS
30 VAN NESS AVENUE, 5TH FLOOR
SAN FRANCISCO, CA 94102 - 6028

Section Mgr:	<i>Eric T. Vellberg</i>	DATE:	5/16/18
Deputy Division Mgr:	<i>Pat & Ann</i>	DATE:	5/16/18
Division Mgr:	<i>Patrick Rivera</i>	DATE:	5/16/18

DESIGNED:	A. EHSAEI	DATE:	04/18
DRAWN:	B. CARPENTER	DATE:	04/18
CHECKED:	T. SWEET	DATE:	04/18

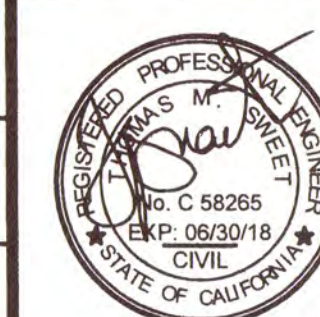

SCALE:	1" = 5'
SHEET OF SHEETS	28 OF 89

VARIOUS LOCATIONS PAVEMENT
RENOVATION NO. 37 AND SEWER REPLACEMENT

VERMONT STREET AND 20TH STREET
CURB RAMP DETAILS

CONTRACT NO.	2792J
DRAWING NO.	CR-05
FILE NO.	109.967
REV. NO.	

NO.	DATE	DESCRIPTION	BY	APP.
TABLE OF REVISIONS				
THIS DRAWING WAS LAST MODIFIED: 11/29/17 17:45, BY: joseph.burg				

Xrefs: T:\SFPDW Various Locations 37 (2792J)\Plan\XC-2792J-BOT Title Block.dwg
T:\SFPDW Various Locations 37 (2792J)\Plan\XC-TOPO VERMONT AND 20TH.dwg
T:\SFPDW Various Locations 37 (2792J)\Plan\XC-DESIGN VERMONT AND 20TH.dwg
Dimension Scale: 5
Model Units: Undefined
Drawing Path: T:\SFPDW Various Locations 37 (2792J)\Sheet\CR-05.dwg, Login: joseph.burg
Plot Time: Mon, 23 Apr 2018 - 7:08pm