




MH CONNECTION DETAIL 1

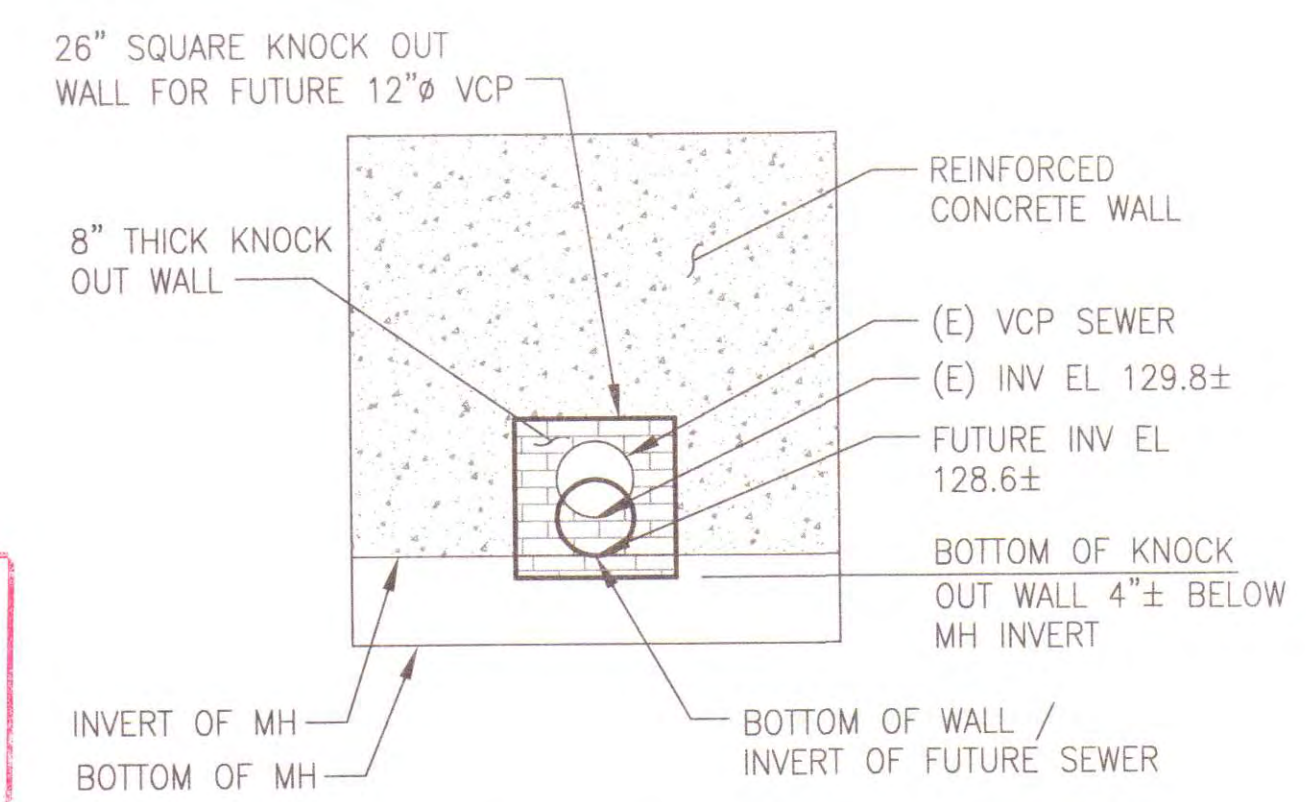

KNOCK OUT WALL DETAIL 2 SW-17

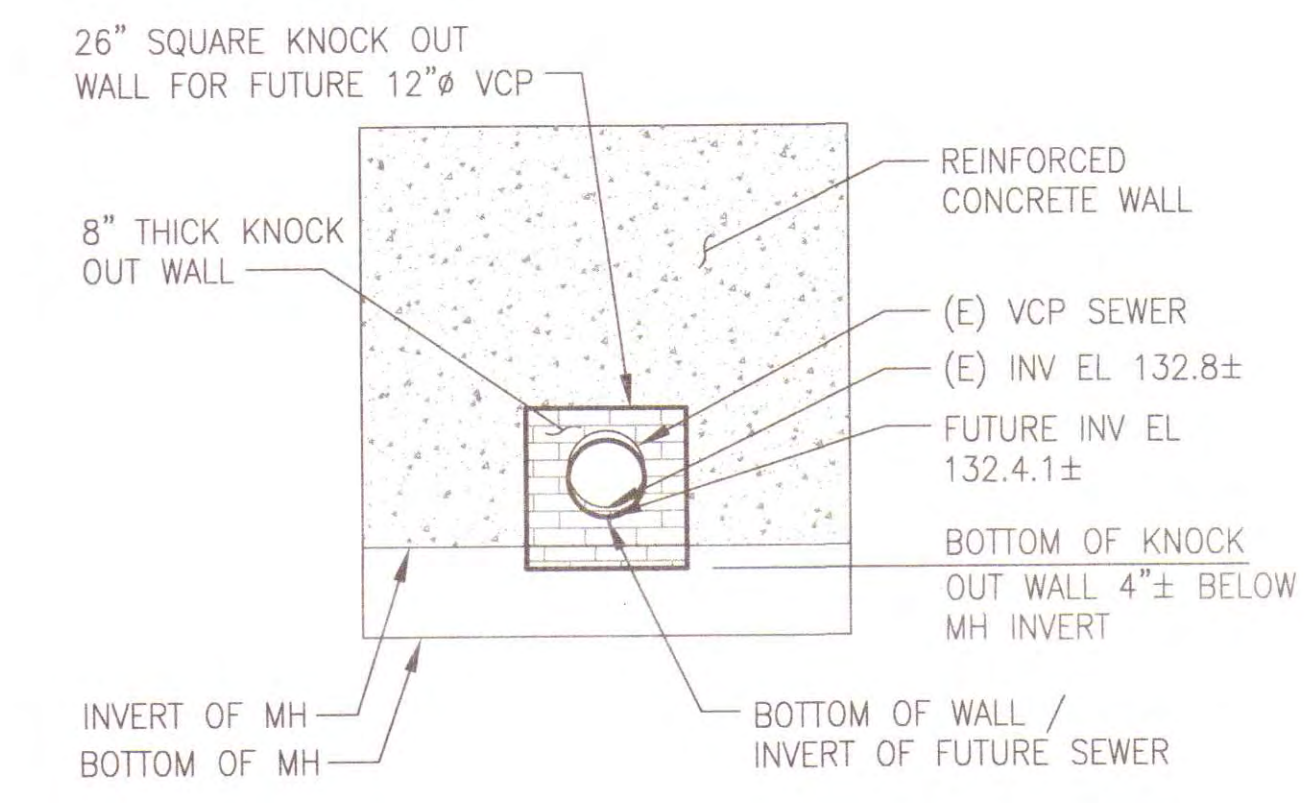

KNOCK OUT WALL DETAIL 3 SW-17

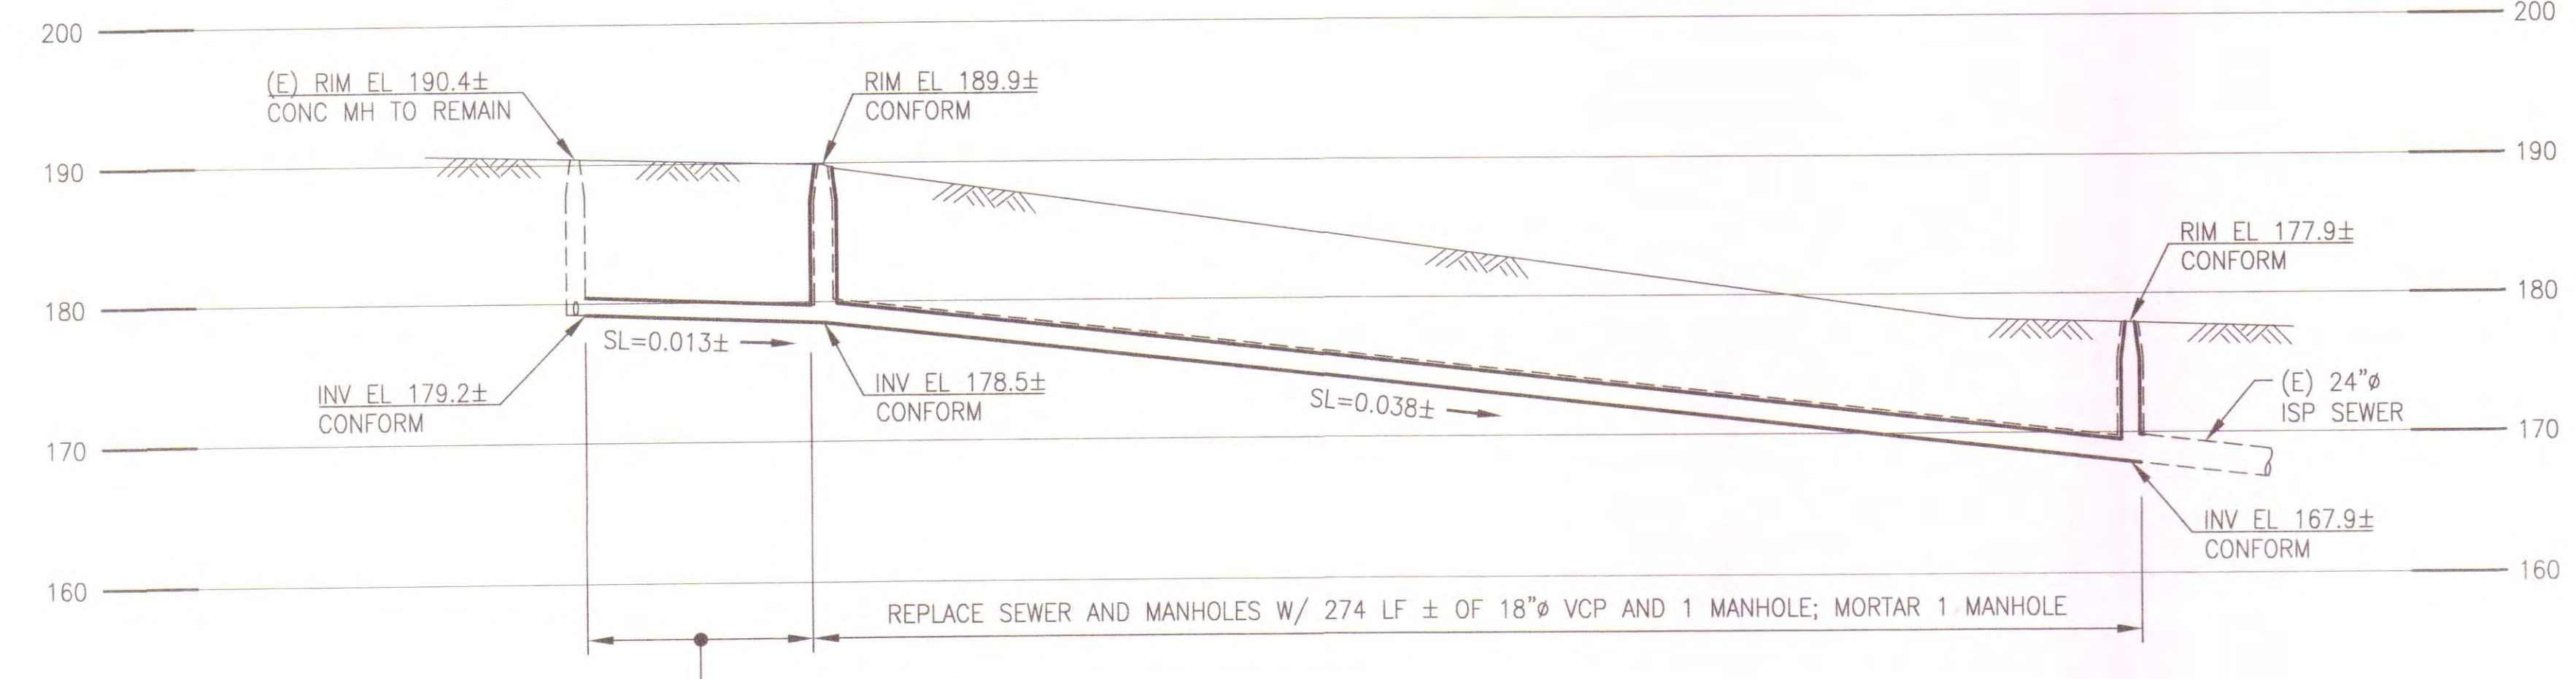

PROFILE SCALE: HORIZ 1"=30' VERT 1"=10'

PRECISION
ENGINEERING
1939 NEWCOMB AVENUE
SAN FRANCISCO, CA 94124
AS BUILT DRAWINGS
Sign *[Signature]*

SEWER SIZED BY
B.A. *[Signature]*
APPROVED BY
B.S. *[Signature]*

NO.	DATE	DESCRIPTION	BY	APP.


REFERENCE INFORMATION
& FILE NO. OF SURVEYS
A-6732
A-993
BK-035_PG-054
P2-002
P2-007



DESIGN & ENGINEERING
CITY & COUNTY OF SAN FRANCISCO
SAN FRANCISCO PUBLIC WORKS
30 VAN NESS AVENUE, 5TH FLOOR
SAN FRANCISCO, CA 94102 - 6028

Section Mgr:	LESLEY WONG	Date:	4/25/18
Deputy Bureau Mgr:	IQBAL DHAPA	Date:	4/27/18
Bureau Mgr:	PATRICK RIVERA	Date:	4/27/18

DESIGNED:	J. KUNG	DATE:	4/2018
DRAWN:	S. HUEY	DATE:	4/2018
CHECKED:	J. HELMUTH	DATE:	4/2018

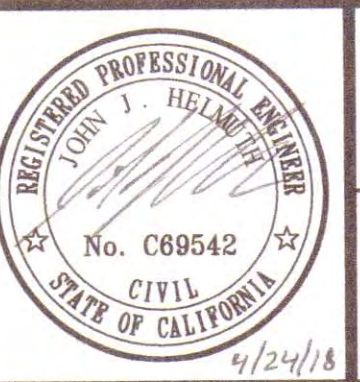

SCALE:
AS NOTED
SHEET OF SHEETS
65 OF 89

VARIOUS LOCATIONS PAVEMENT
RENOVATION NO. 37 AND SEWER REPLACEMENT
CALIFORNIA STREET SEWER REPLACEMENT
31ST AVENUE TO 32ND AVENUE
PLAN, PROFILE AND DETAILS

CONTRACT NO.	2792J
DRAWING NO.	SW-15
FILE NO.	110,003
REV. NO.	0