





PRECISION
ENGINEERING
1939 NEWCOMB AVENUE
SAN FRANCISCO, CA 94124

AS BUILT
DRAWINGS
Sign *[Signature]*

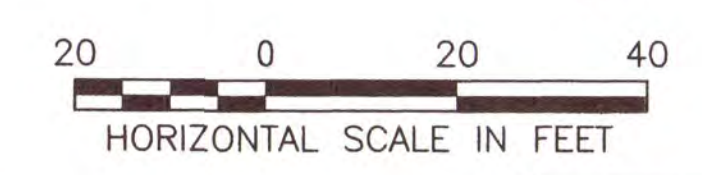

<table border="1"><thead><tr><th>NO.</th><th>DATE</th><th>DESCRIPTION</th><th>BY</th><th>APP.</th></tr></thead><tbody><tr><td colspan="5">TABLE OF REVISIONS</td></tr><tr><td colspan="5">THIS DRAWING WAS LAST MODIFIED: 04/26/18 09:03, BY: L.Louie</td></tr></tbody></table>		NO.	DATE	DESCRIPTION	BY	APP.	TABLE OF REVISIONS					THIS DRAWING WAS LAST MODIFIED: 04/26/18 09:03, BY: L.Louie					REFERENCE INFORMATION & FILE NO. OF SURVEYS				 <p>DESIGN & ENGINEERING CITY & COUNTY OF SAN FRANCISCO SAN FRANCISCO PUBLIC WORKS 30 VAN NESS AVENUE, 5TH FLOOR SAN FRANCISCO, CA 94102 - 6028</p>		<table border="1"><tr><td>Section Mgr:</td><td><i>Em T. [Signature]</i></td><td>Date:</td><td>5/16/18</td></tr><tr><td>Deputy Division Mgr:</td><td>FERNANDO CISNEROS</td><td>Date:</td><td>5/16/18</td></tr><tr><td>Division Mgr:</td><td>PATRICK RIVERA</td><td>Date:</td><td>5/16/18</td></tr></table>		Section Mgr:	<i>Em T. [Signature]</i>	Date:	5/16/18	Deputy Division Mgr:	FERNANDO CISNEROS	Date:	5/16/18	Division Mgr:	PATRICK RIVERA	Date:	5/16/18	<table border="1"><tr><td>DESIGNED:</td><td>L.LOUIE</td><td>DATE:</td><td>02/18</td></tr><tr><td>DRAWN:</td><td>J.BLEA</td><td>DATE:</td><td>02/18</td></tr><tr><td>CHECKED:</td><td>D.CALLEROS</td><td>DATE:</td><td>03/18</td></tr></table>		DESIGNED:	L.LOUIE	DATE:	02/18	DRAWN:	J.BLEA	DATE:	02/18	CHECKED:	D.CALLEROS	DATE:	03/18			SCALE: 1" = 20' SHEET OF SHEETS 13 OF 89		<p>VARIOUS LOCATIONS PAVEMENT RENOVATION NO. 37 AND SEWER REPLACEMENT</p> <p>PAVEMENT PLAN KANSAS ST 17TH ST TO 16TH ST</p>		<p>EHY JO NO. 2963J</p> <table border="1"><tr><td>CONTRACT NO.</td><td>2792J</td></tr><tr><td>DRAWING NO.</td><td>R-8</td></tr><tr><td>FILE NO.</td><td>109,952</td></tr><tr><td>REV. NO.</td><td></td></tr></table>		CONTRACT NO.	2792J	DRAWING NO.	R-8	FILE NO.	109,952	REV. NO.	
NO.	DATE	DESCRIPTION	BY	APP.																																																														
TABLE OF REVISIONS																																																																		
THIS DRAWING WAS LAST MODIFIED: 04/26/18 09:03, BY: L.Louie																																																																		
Section Mgr:	<i>Em T. [Signature]</i>	Date:	5/16/18																																																															
Deputy Division Mgr:	FERNANDO CISNEROS	Date:	5/16/18																																																															
Division Mgr:	PATRICK RIVERA	Date:	5/16/18																																																															
DESIGNED:	L.LOUIE	DATE:	02/18																																																															
DRAWN:	J.BLEA	DATE:	02/18																																																															
CHECKED:	D.CALLEROS	DATE:	03/18																																																															
CONTRACT NO.	2792J																																																																	
DRAWING NO.	R-8																																																																	
FILE NO.	109,952																																																																	
REV. NO.																																																																		

Xrefs: V:\2963J Various Locations Sewer Replacement-JV with VL PR No.37 Official Project TBs\DE1_TB_22x34.dwg
V:\2963J Various Locations Sewer Replacement-JV with VL PR No.37 Design Working Drawings\EHY\2963J_SW1
V:\2963J Various Locations Sewer Replacement-JV with VL PR No.37 Design Working Drawings\EHY\2963J_SW4
V:\2963J Various Locations Sewer Replacement-JV with VL PR No.37 Design Working Drawings\EHY\2963J_SW5
Drawing Path: V:\2963J Various Locations Sewer Replacement-JV with VL PR No.37 Official Project TBs\DE1_TB_22x34.dwg
Plot Time: Thu, 26 Apr 2018 - 9:06am
Login: L.Louie
Model Units: Feet