





PRECISION
ENGINEERING
1939 NEWCOMB AVENUE
SAN FRANCISCO, CA 94124

**AS BUILT
DRAWINGS**
Sign *[Signature]*

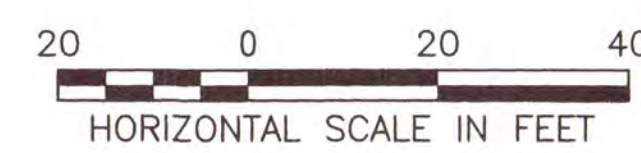

					REFERENCE INFORMATION & FILE NO. OF SURVEYS				 <p>DESIGN & ENGINEERING CITY & COUNTY OF SAN FRANCISCO SAN FRANCISCO PUBLIC WORKS 30 VAN NESS AVENUE, 5TH FLOOR SAN FRANCISCO, CA 94102 - 6028</p>		<table><tr><td>Section Mgr:</td><td><i>Eric T. Kibbey</i></td><td>Date:</td><td>5/16/18</td></tr><tr><td>Deputy Division Mgr:</td><td><i>Fernando Cisneros</i></td><td></td><td>5/16/18</td></tr><tr><td>Division Mgr:</td><td><i>Patrick Rivera</i></td><td></td><td>5/16/18</td></tr></table>		Section Mgr:	<i>Eric T. Kibbey</i>	Date:	5/16/18	Deputy Division Mgr:	<i>Fernando Cisneros</i>		5/16/18	Division Mgr:	<i>Patrick Rivera</i>		5/16/18			SCALE: 1" = 20' SHEET OF SHEETS 15 OF 89		VARIOUS LOCATIONS PAVEMENT RENOVATION NO. 37 AND SEWER REPLACEMENT PAVEMENT PLAN DE HARO ST - 16TH ST TO 17TH ST 18TH ST - DE HARO ST TO CAROLINA ST		CONTRACT NO. 2792J DRAWING NO. R-10 FILE NO. 109,954 REV. NO.				
Section Mgr:	<i>Eric T. Kibbey</i>	Date:	5/16/18																																
Deputy Division Mgr:	<i>Fernando Cisneros</i>		5/16/18																																
Division Mgr:	<i>Patrick Rivera</i>		5/16/18																																
<table><tr><td>NO.</td><td>DATE</td><td>DESCRIPTION</td><td>BY</td><td>APP.</td></tr><tr><td colspan="5">TABLE OF REVISIONS</td></tr><tr><td colspan="5">THIS DRAWING WAS LAST MODIFIED: 04/26/18 09:03, BY: LLouie</td></tr></table>					NO.	DATE	DESCRIPTION	BY	APP.	TABLE OF REVISIONS					THIS DRAWING WAS LAST MODIFIED: 04/26/18 09:03, BY: LLouie																				
NO.	DATE	DESCRIPTION	BY	APP.																															
TABLE OF REVISIONS																																			
THIS DRAWING WAS LAST MODIFIED: 04/26/18 09:03, BY: LLouie																																			

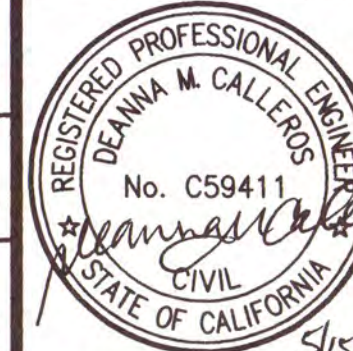Xrefs: V:\2963J_Various_Locations_Sewer_Replacement-IV_with_VL_PR_No.37\Official_Project\Tb\001_TB_22-34.dwg
V:\2963J_Various_Locations_Sewer_Replacement-IV_with_VL_PR_No.37\2_Design_Working_Drawings\EHY\2963J_SW_18th - Arkansas 1
V:\2963J_Various_Locations_Sewer_Replacement-IV_with_VL_PR_No.37\2_Design_Working_Drawings\EHY\2963J_SW_Connecticut - 16th
V:\2963J_Various_Locations_Sewer_Replacement-IV_with_VL_PR_No.37\2_Design_Working_Drawings\EHY\2963J_SW_Connecticut - 16th

Drawing Path: V:\2792J_Various_Locations_No.37_Pavement_Renovation\2_Design_Working_Drawings\ESH\Current\2792J\2792J-03-18.dwg
Plot Time: Thu, 26 Apr 2018 - 9:07am
Login: Llouie
Model Units: Feet
Measurement Units are English