

PRECISION ENGINEERING
1939 NEWCOMB AVENUE
SAN FRANCISCO, CA 94124

**AS BUILT
DRAWINGS**
Sign *[Signature]*

VERMONT STREET

REFER TO FILE 109,961
REVISION 0 FOR
MANAGEMENT SIGNATURES

NOTES:

- TOPOGRAPHIC SURVEY PERFORMED BY TELAMON ENGINEERING CONSULTANTS, INC. IN NOVEMBER, 2016 USING AN ASSUMED HORIZONTAL AND VERTICAL DATUM, SEE REFERENCE POINT ON TOP OF LPFH (EL=10.00).
- PROPERTY LINE IS APPROXIMATE AND BASED ON THE LATEST GRADE MAP INFORMATION OBTAINED FROM THE CITY & COUNTY OF SAN FRANCISCO DEPARTMENT OF PUBLIC WORKS (SFPW) WEBSITE: "HTTP://BSM.SFPW.ORG/SUBDIVISION/KEYMAP/."
- FACE OF CURB RADIUS AS NOTED.
- ADJUST CB GRATE HORIZONTALLY TO NEW CURB ALIGNMENT.

AECOM 300 California Street, Suite 600
San Francisco, CA 94104
Tel: 415-796-8100
Fax: 415-796-8200

REFERENCE INFORMATION
& FILE NO. OF SURVEYS



DESIGN & ENGINEERING
CITY & COUNTY OF SAN FRANCISCO
SAN FRANCISCO PUBLIC WORKS
30 VAN NESS AVENUE, 5TH FLOOR
SAN FRANCISCO, CA 94102-6028

Section Mgr:
Deputy Division Mgr:
Division Mgr:

Date:





DESIGNED: DATE:
A. EHSAEI 04/18
DRAWN: DATE:
B. CARPENTER 04/18
CHECKED: DATE:
T. SWEET 04/18



SCALE:
1" = 5'
SHEET OF SHEETS
OF

VARIOUS LOCATIONS PAVEMENT
RENOVATION NO. 37 AND SEWER REPLACEMENT
VERMONT STREET AND MARIPOSA STREET
CURB RAMP DETAILS

CONTRACT NO.
2792J
DRAWING NO.
CR-01
FILE NO.
109,961
REV. NO.
1

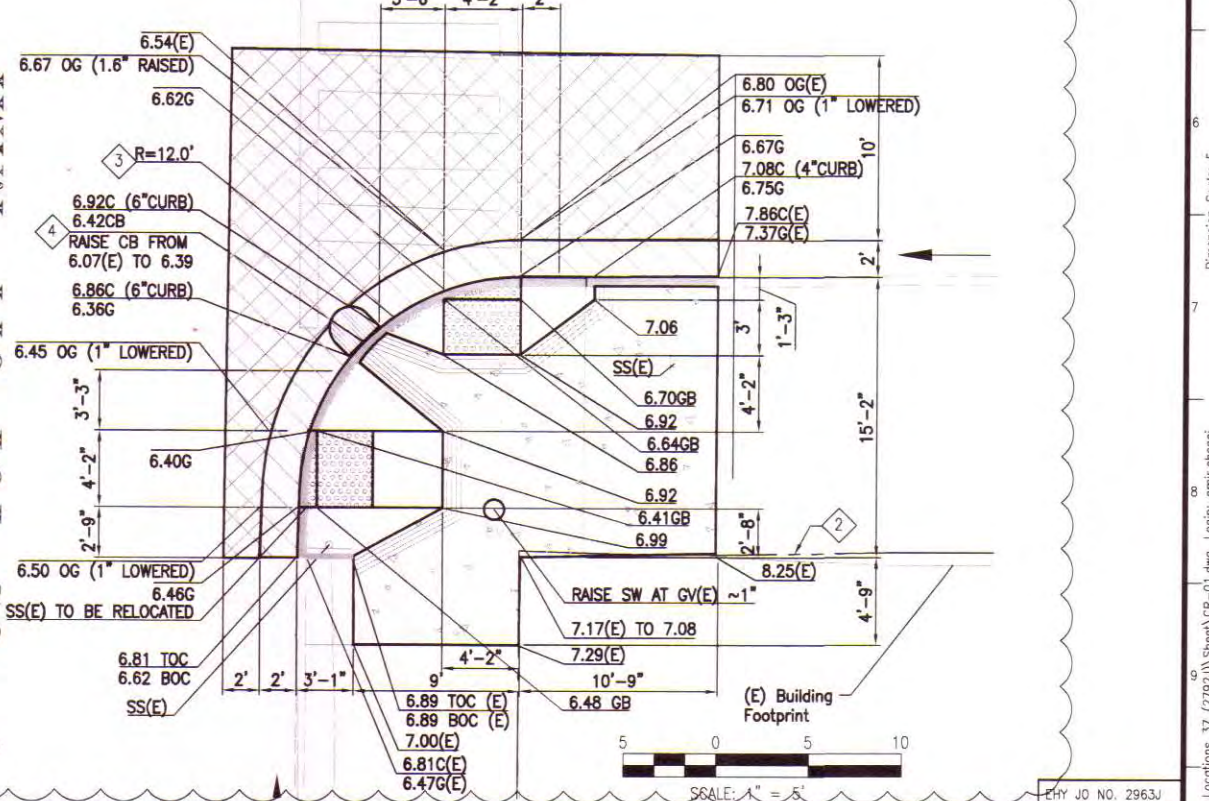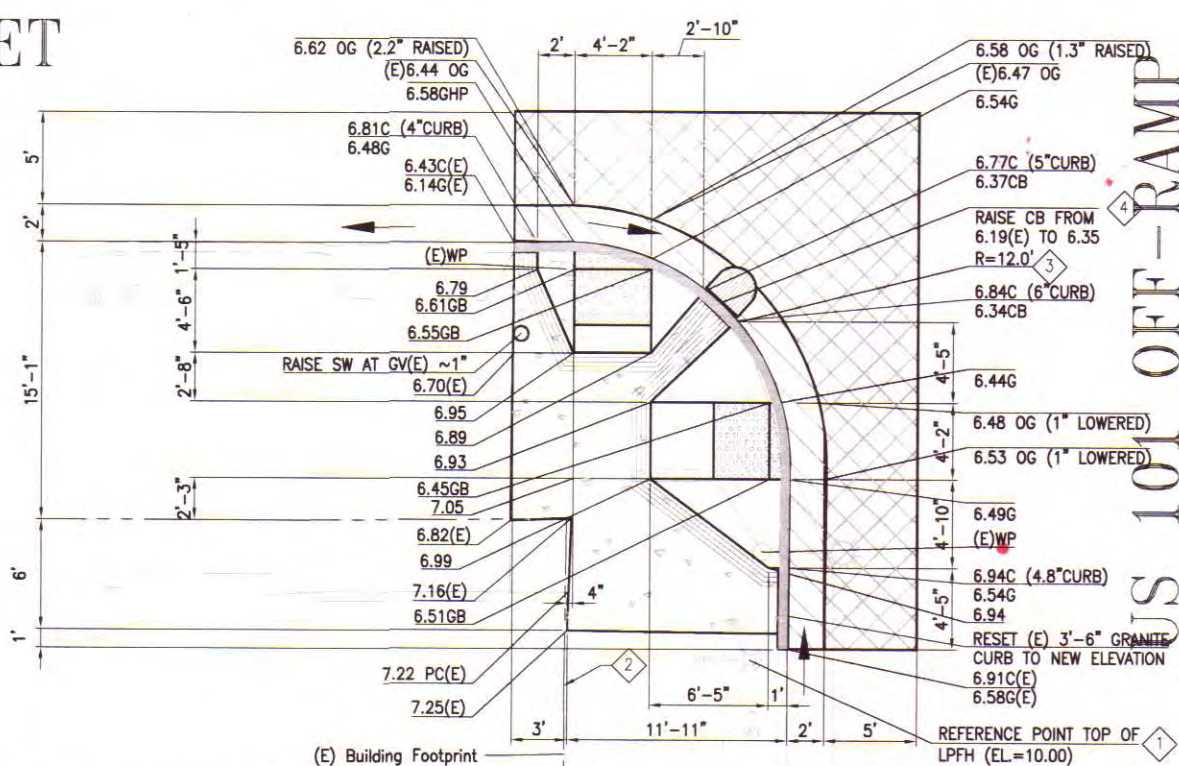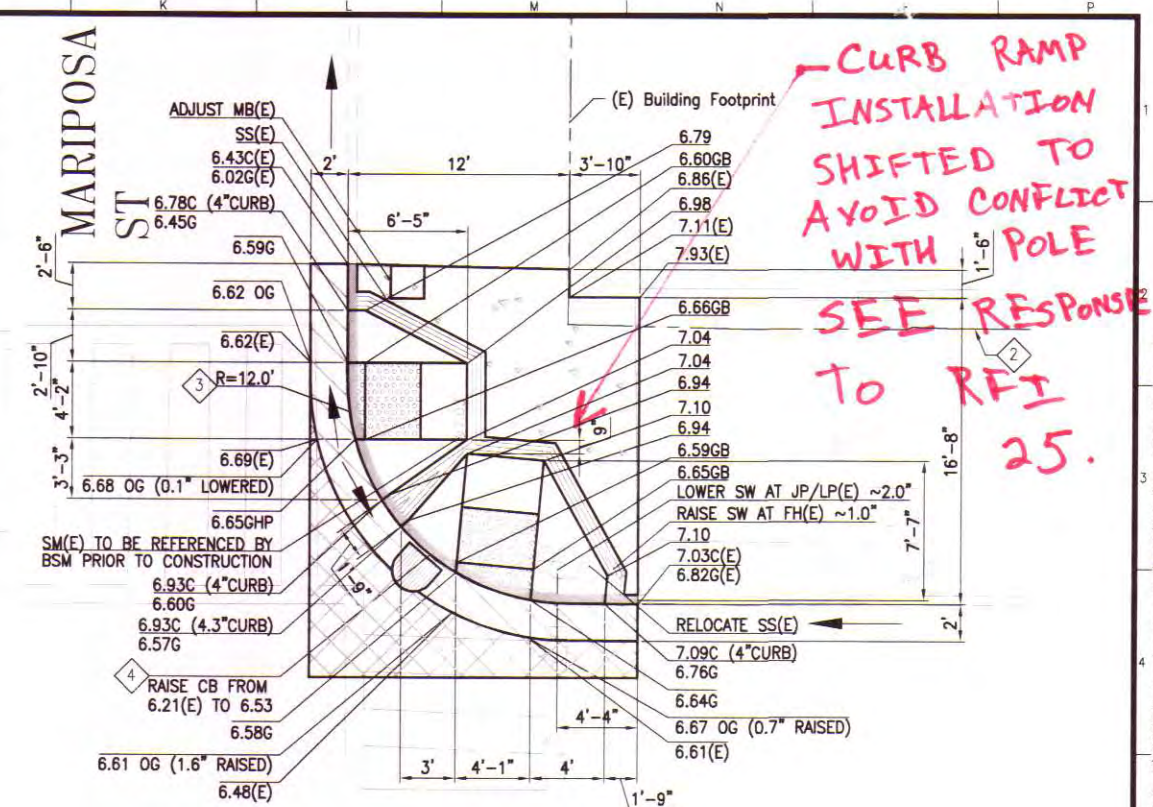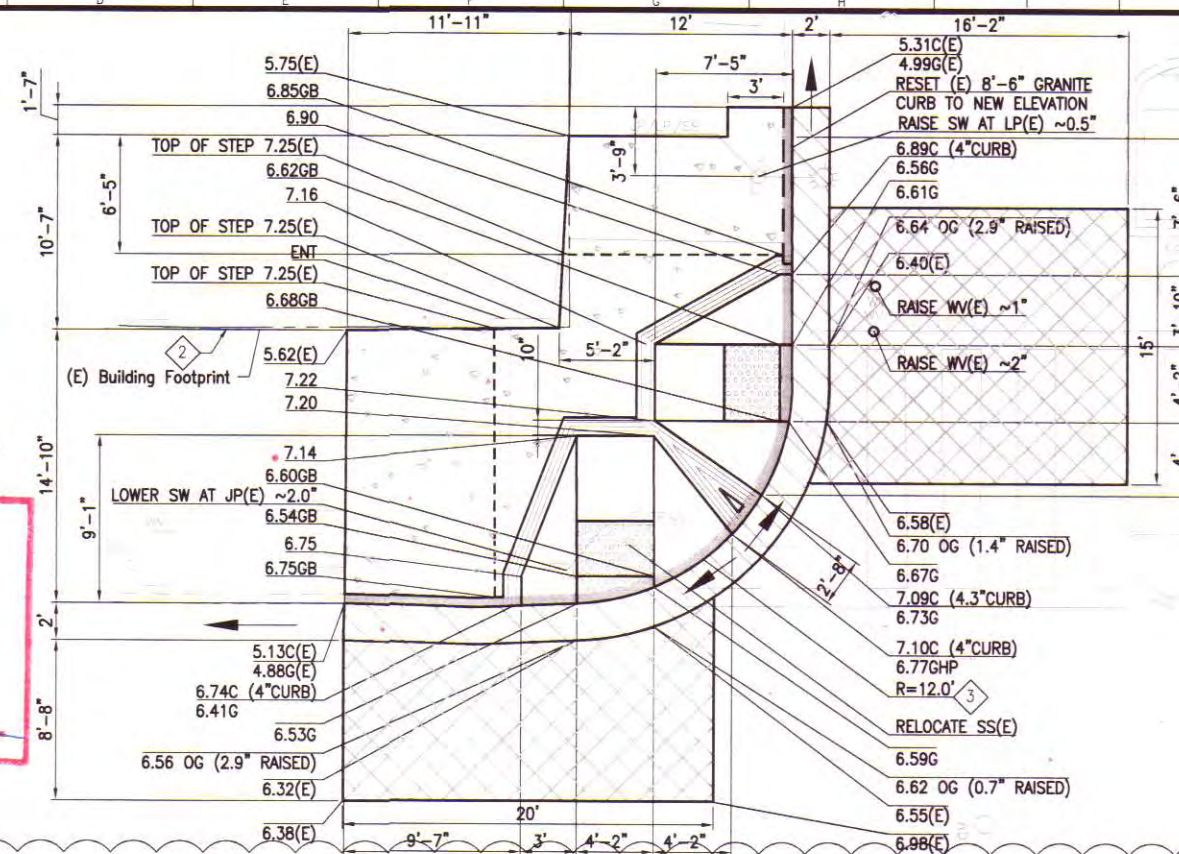

Drawing Path: T:\SFPW Various Locations 37 (2792)\Vermont Street\CR-01.dwg, Login: amir.ehsaei
Plot Time: Thu, 25 Apr 2019 - 11:34am
Dimension Scale: 5
Model Units: Undefined
Measurement Units are English
E:\J0 NO. 2963J