


1. TOPOGRAPHIC SURVEY PERFORMED BY TELAMON ENGINEERING CONSULTANTS, INC. IN MAY 2015 USING AN ASSUMED HORIZONTAL AND VERTICAL DATUM, SEE REFERENCE POINT ON TOP OF LPFH.
2. PROPERTY LINE IS APPROXIMATE AND BASED ON THE LATEST GRADE MAP INFORMATION OBTAINED FROM THE CITY & COUNTY OF SAN FRANCISCO DEPARTMENT OF PUBLIC WORKS (SFPDW) WEBSITE: "<http://BSM.SFPDW.ORG/SUBDIVISION/KEYMAP/>".
3. FACE OF CURB RADIUS AS NOTED.
4. ADJUST CATCH BASIN AND GRATE TO NEW CURB ALIGNMENT.
5. CONTACT BUREAU OF STREET USE AND MAPPING TO COORDINATE MODIFICATION OF MONUMENT PRIOR TO CONSTRUCTION.



15TH STREET



AS BUILT
DRAWINGS
Sign 

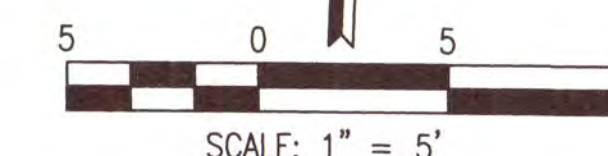

REFERENCE INFORMATION
& FILE NO. OF SURVEYS



DESIGN &
ENGINEERING
PUBLIC WORKS
CITY & COUNTY OF SAN FRANCISCO
30 VAN NESS AVENUE, 5TH FLOOR
SAN FRANCISCO, CA 94102 - 6028

Section Mgr:	<i>Eric T. Kibbey</i>	Date:	5/16/18
Deputy Division Mgr:	FERNANDO CISNEROS		
	<i>Sub</i>		5/16/18
Division Mgr:	PATRICK RIVERA		
	<i>Paul Rivera</i>		5/16/18

DESIGNED:	DATE:
DZ	04/18
DRAWN:	DATE:
KN	04/18
CHECKED:	DATE:
MC	04/18



SCALE:
1" = 5"
SHEET OF SHEETS
40 OF 89

VARIOUS LOCATIONS
RENOVATION NO. 37 AND SEWER REPLACEMENT

15TH ST AND VERMONT ST - NORTH
CURB RAMP DETAILS

EHY JO NO. 2963.

CONTRACT NO.	2792J
DRAWING NO.	CR-16B
FILE NO.	111,647
REV. NO.	

Drawing Path: P:\16014 CRD 2728J VL Trck Remv\3_Dwg CR-16 15TH&VERMONT ST.dwg
 Plot time: Wed, 25 Apr 2016 - 2:07pm
 Measurement Units are English
 Dimension Scale: 5
 Model Units: Feet
 Dimension Scale: 5
 Model Units: Feet
 Xrefs: P:\16014 CRD 2728J VL Trck Remv\3_Dwg Xrefs X-VA-15th and Vermont.dwg
 P:\1607\1_292J CRD WJ#37\3_Dwg Xrefs X-TLB-16053.dwg
 P:\16014 CRD 2728J VL Trck Remv\3_Dwg Xrefs XC-SLOPE-FIG.dwg
 P:\16014 CRD 2728J VL Trck Remv\3_Dwg Xrefs Y-NOTE-0FSC.dwg