


AS BUILT
DRAWINGS
Sign *[Signature]*

PRECISION
ENGINEERING
1939 NEWCOMB AVENUE
SAN FRANCISCO, CA 94124

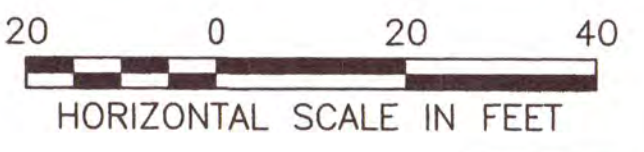

NO.	DATE	DESCRIPTION	BY	APP.
TABLE OF REVISIONS				
THIS DRAWING WAS LAST MODIFIED: 04/26/18 09:03, BY: LLouie				

REFERENCE INFORMATION
& FILE NO. OF SURVEYS



DESIGN & ENGINEERING
CITY & COUNTY OF SAN FRANCISCO
SAN FRANCISCO PUBLIC WORKS
30 VAN NESS AVENUE, 5TH FLOOR
SAN FRANCISCO, CA 94102 - 6028

Section Mgr:	<i>Eve T. Kjeblog</i>	Date:	5/16/18
Deputy Division Mgr:	<i>FERNANDO CISNEROS</i>	5/16/18	
Division Mgr:	<i>PATRICK RIVERA</i>	5/16/18	

DESIGNED:	LL	DATE:	02/18
DRAWN:	LL	DATE:	02/18
CHECKED:		DATE:	
D.CALLEROS		03/18	



SCALE:
1" = 20'
SHEET OF SHEETS
18 OF 89

VARIOUS LOCATIONS PAVEMENT
RENOVATION NO. 37 AND SEWER REPLACEMENT

PAVEMENT PLAN
CALIFORNIA ST
32ND AVE TO 29TH AVE

CONTRACT NO.	2792J
DRAWING NO.	R-13
FILE NO.	109,957
REV. NO.	

Xrefs: V:\29633_Various Locations_Sewer Replacement-JV with VL\PR_No.37\Official_Project_TB\DEI_TB_22234.dwg
V:\29633_Various Locations_Sewer Replacement-JV with VL\PR_No.37\2_Design_Working_Drawings_VERY\29633_SW1_18th - Arkansas t
V:\29633_Various Locations_Sewer Replacement-JV with VL\PR_No.37\2_Design_Working_Drawings_VERY\29633_SW4_Connecticut - 18th
V:\29633_Various Locations_Sewer Replacement-JV with VL\PR_No.37\2_Design_Working_Drawings_VERY\29633_SW5_Connecticut - 18th

Drawing Path: V:\2792J_Various Locations_2_Design_Working_Drawings\ESH\Current\2792J\29633.dwg
Plot Time: Thu, 26 Apr 2018 - 9:20am
Model Units: Feet
Login: LLouie