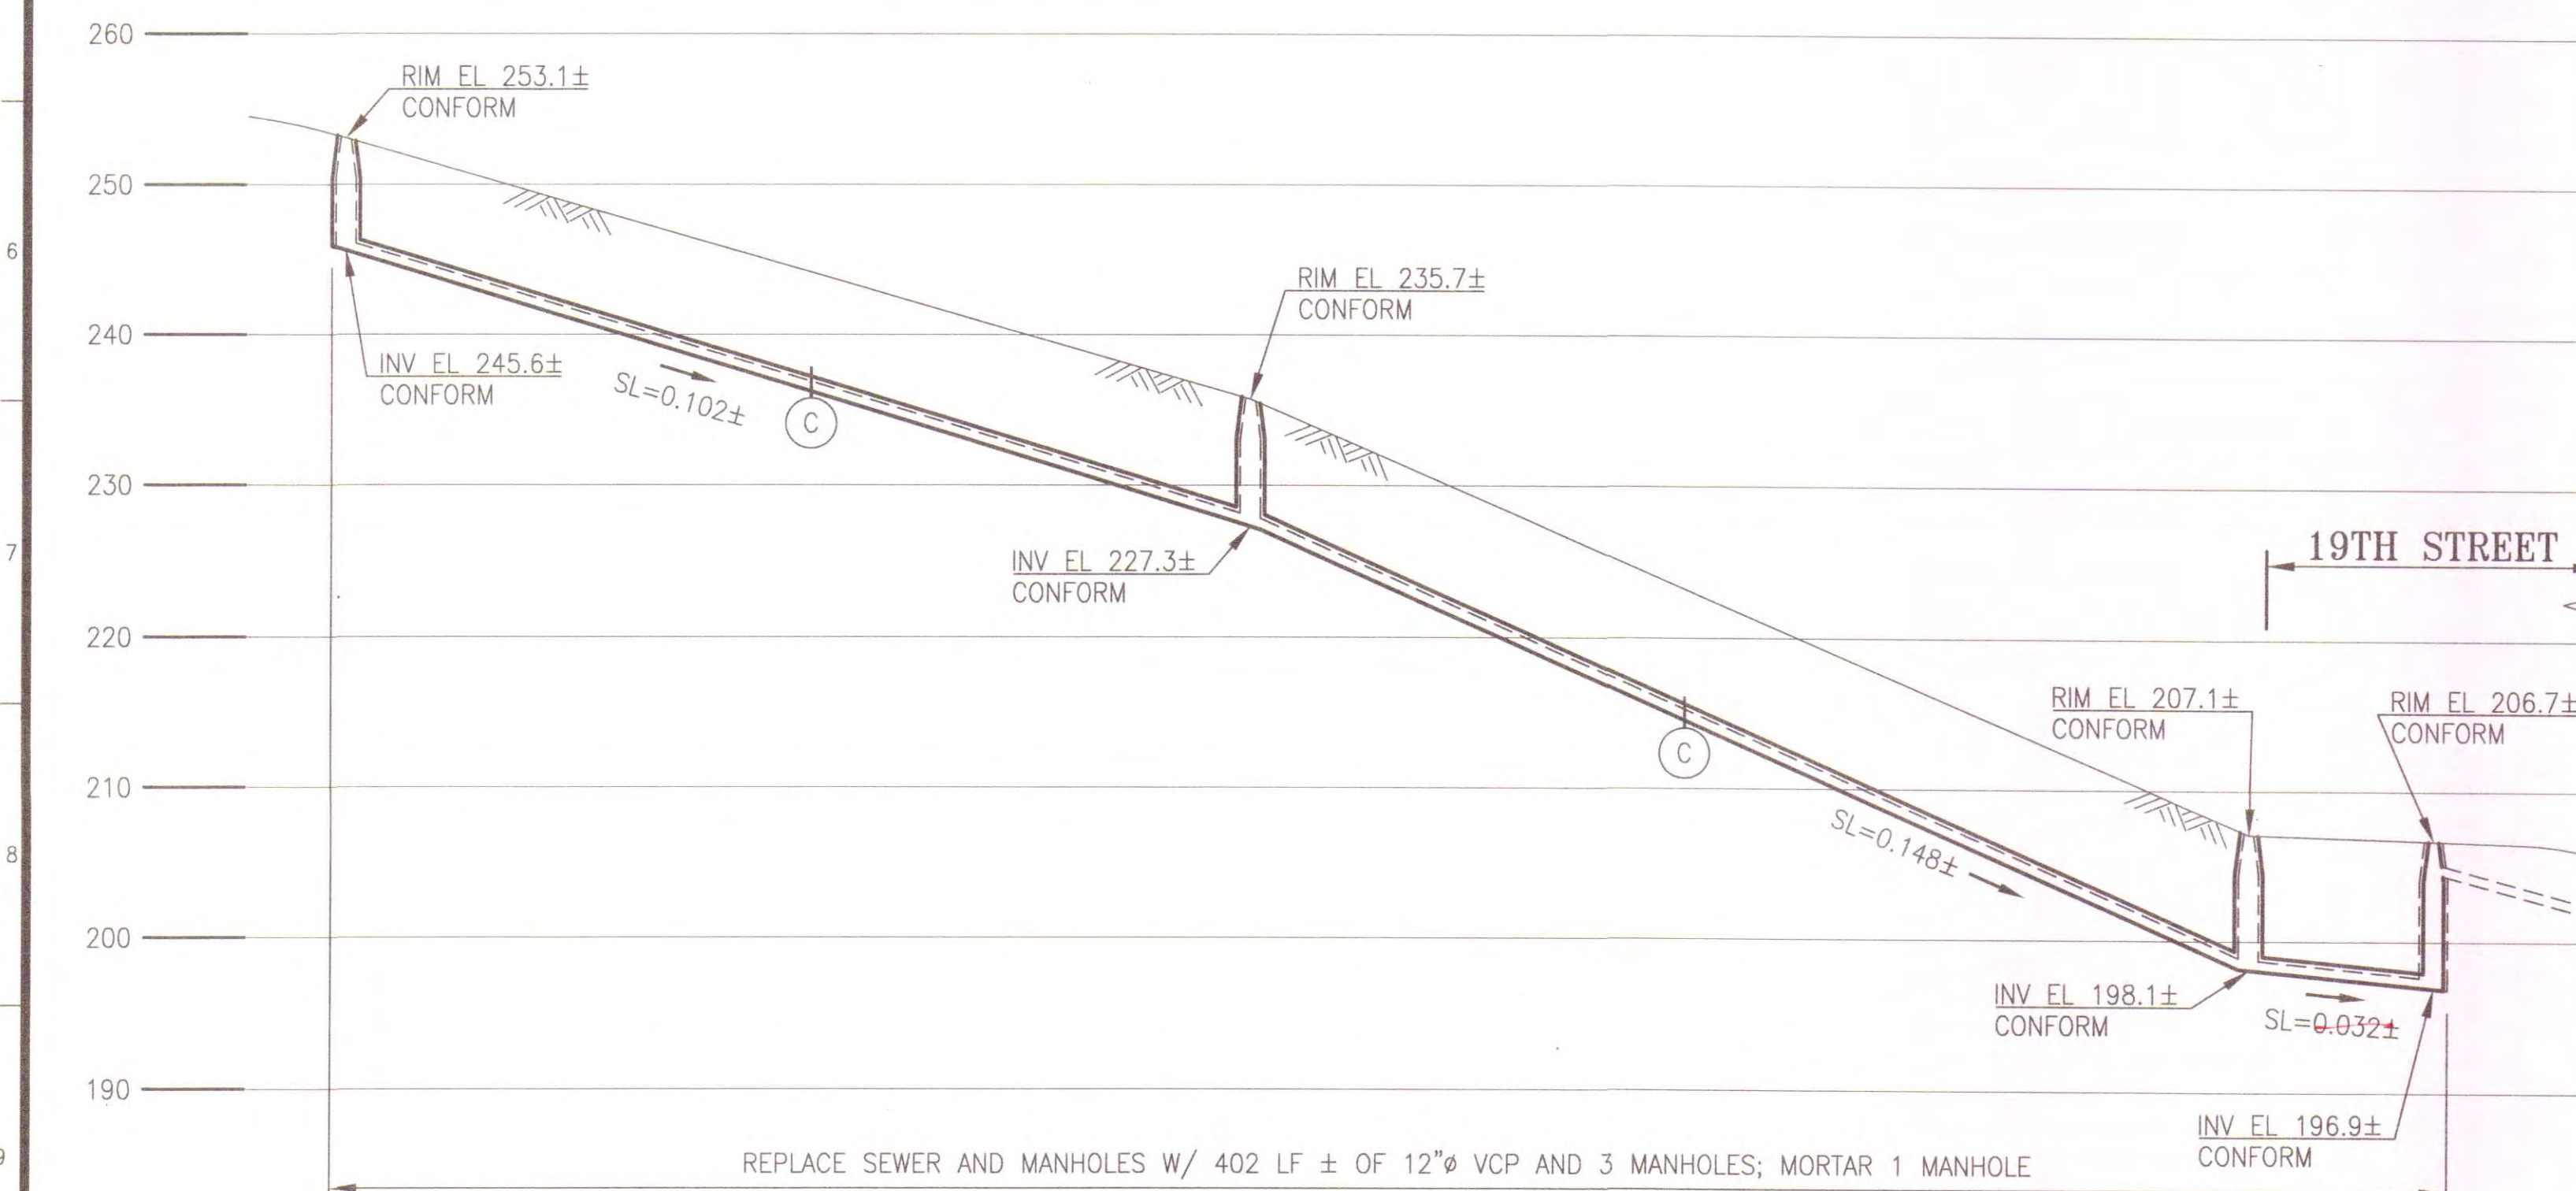


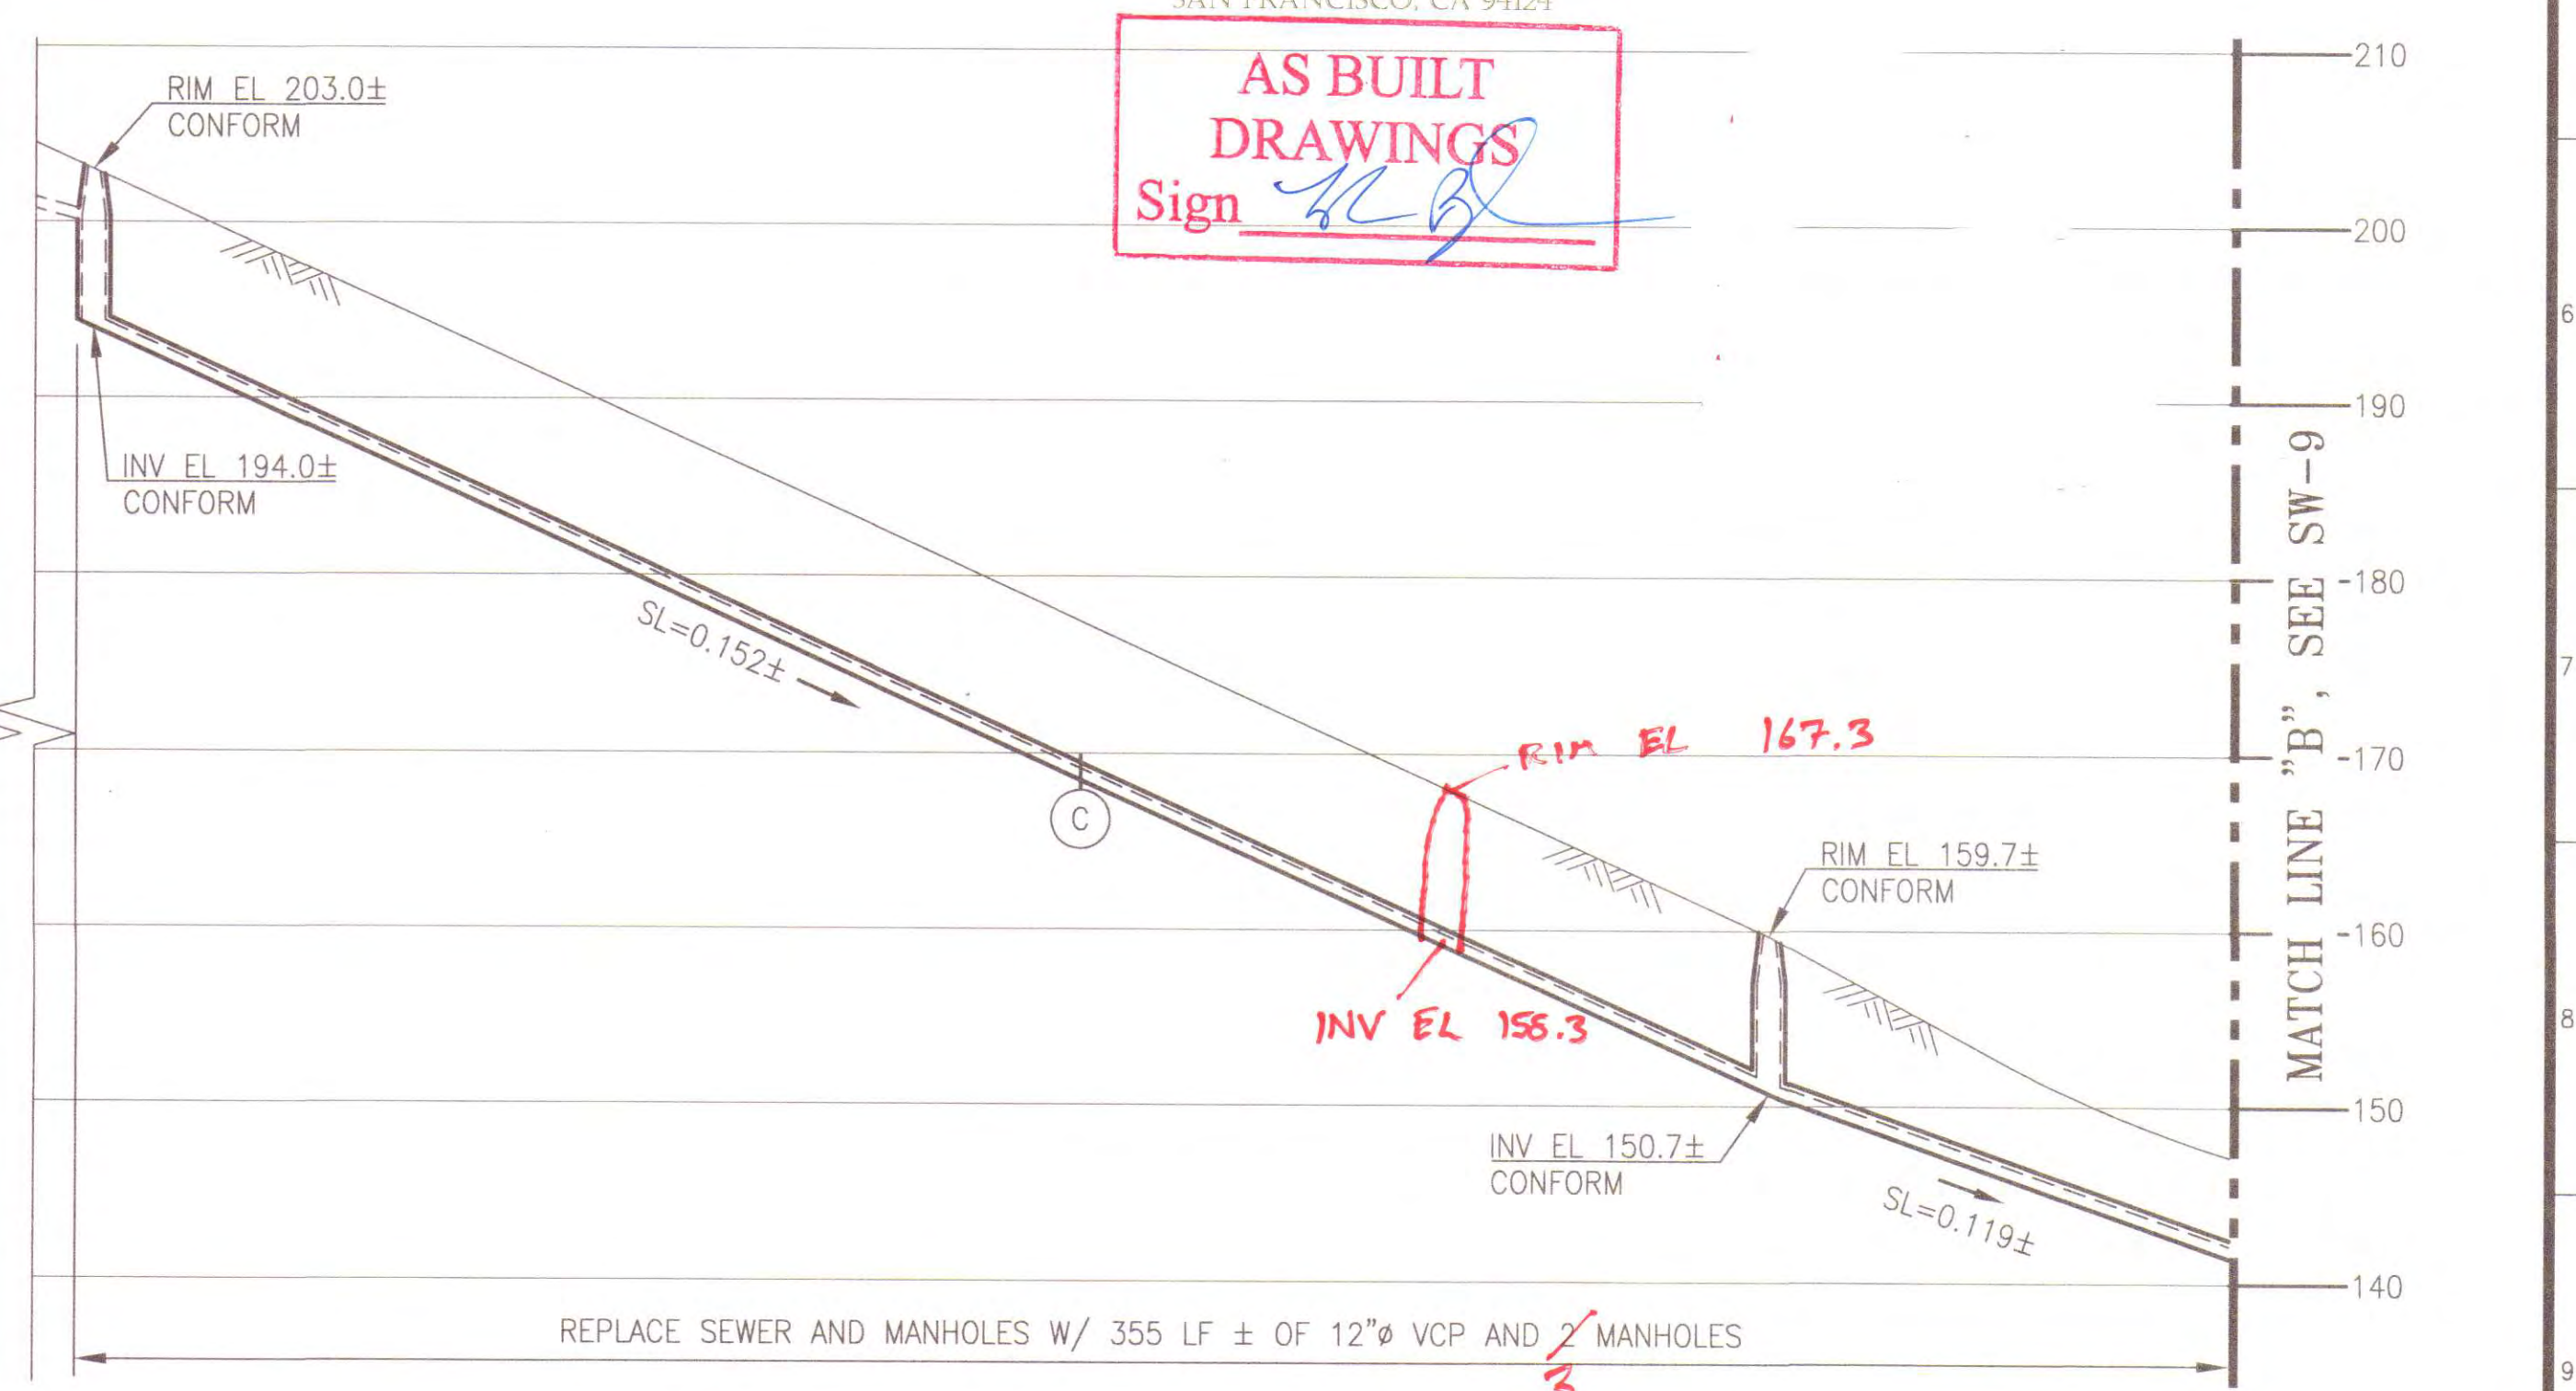
PLAN  
SCALE: 1"=30'

PRECISION  
ENGINEERING  
1939 NEWCOMB AVENUE  
SAN FRANCISCO, CA 94124

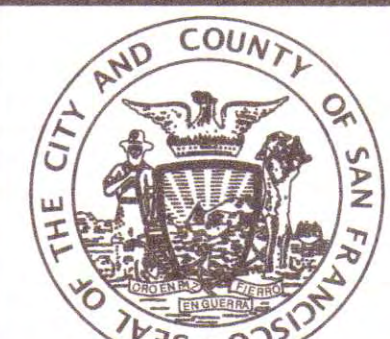
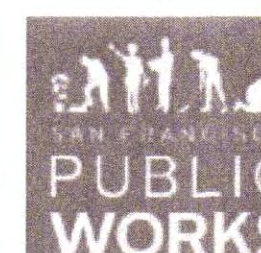
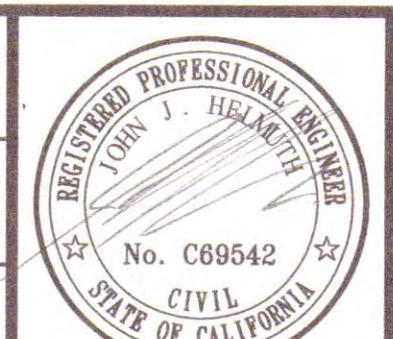
AS BUILT  
DRAWINGS  
Sign *[Signature]*



PROFILE  
SCALE: HORIZ 1"=30'  
VERT 1"=10'



HORIZONTAL SCALE: 1"=30'  
VERTICAL SCALE: 1"=10'

SEWER SIZED BY Y.W. <i>[Signature]</i>		APPROVED BY B.S. <i>[Signature]</i>		REFERENCE INFORMATION & FILE NO. OF SURVEYS EX-0416 P3-544 PH-046						DESIGN & ENGINEERING CITY & COUNTY OF SAN FRANCISCO SAN FRANCISCO PUBLIC WORKS 30 VAN NESS AVENUE, 5TH FLOOR SAN FRANCISCO, CA 94102 - 6028		Section Mgr: <i>[Signature]</i> LESLEY WONG 4/25/18 Deputy Bureau Mgr: <i>[Signature]</i> IQBAL DHAPA 4/27/18 Bureau Mgr: <i>[Signature]</i> PATRICK RIVERA 4/27/18		Date: 4/25/18 DESIGNED: J. KUNG 4/2018 DRAWN: S. HUEY 4/2018 CHECKED: J. HELMUTH 4/2018				SCALE: AS NOTED SHEET OF SHEETS: 58 OF 89		VARIOUS LOCATIONS PAVEMENT RENOVATION NO. 37 AND SEWER REPLACEMENT KANSAS STREET SEWER REPLACEMENT MATCH LINE "A" TO 18TH ST (MATCH LINE "B") PLAN AND PROFILE		CONTRACT NO. 2792J DRAWING NO. SW-8 FILE NO. 109,996 REV. NO. 0	
---	--	--	--	---	--	---	--	--	--	---	--	---	--	--	--	---	--	--	--	--	--	--	--