

MATCH LINE "T", SEE SHEET R-14


25TH AVENUE

CALIFORNIA STREET

24TH AVENUE


PRECISION
1939 NEWCOMB AVENUE
SAN FRANCISCO, CA 94124

AS BUILT
DRAWINGS
Sign *[Signature]*

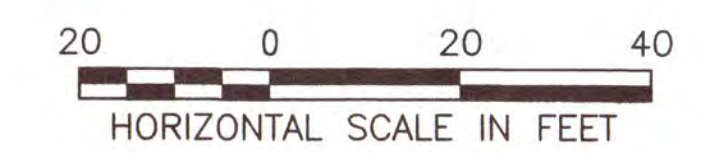

NO.	DATE	DESCRIPTION	BY	APP.
THIS DRAWING WAS LAST MODIFIED: 04/26/18 09:03, BY: L.Louie				


REFERENCE INFORMATION & FILE NO. OF SURVEYS
--

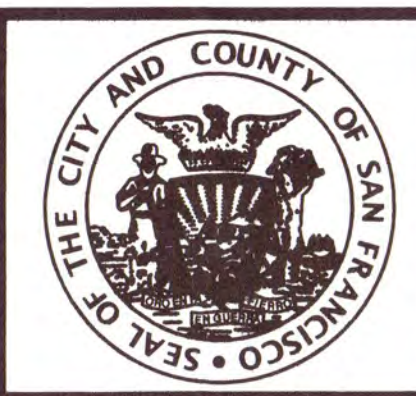

DESIGN & ENGINEERING
CITY & COUNTY OF SAN FRANCISCO
SAN FRANCISCO PUBLIC WORKS
30 VAN NESS AVENUE, 5TH FLOOR
SAN FRANCISCO, CA 94102 - 6028

Section Mgr:	<i>Eric T. Kibler</i>	Date:	5/16/18
Deputy Division Mgr:	<i>Fernando Cisneros</i>	Date:	5/16/18
Division Mgr:	<i>Patrick Rivera</i>	Date:	5/16/18

DESIGNED:	L.LOUIE	DATE:	02/18
DRAWN:	L.LOUIE	DATE:	02/18
CHECKED:	D.CALLEROS	DATE:	03/18

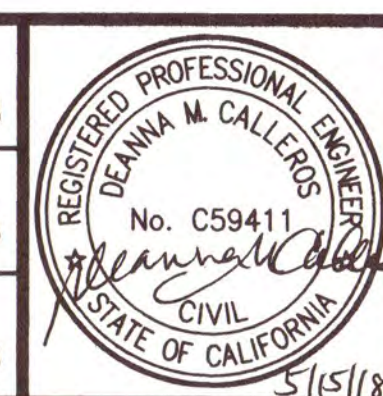

SCALE:	1" = 20'
SHEET OF SHEETS	20 OF 89

VARIOUS LOCATIONS PAVEMENT
RENOVATION NO. 37 AND SEWER REPLACEMENT

PAVEMENT PLAN
CALIFORNIA ST
25TH AVE TO 24TH AVE

CONTRACT NO.	2792J
DRAWING NO.	R-15
FILE NO.	109,959
REV. NO.	

Drawing Path: V:\2792J_Various_Locations_No.37_Pavement_Renovation\2_Design_Working_Drawings\ESH\Current\2792J\AsBuilt\ASBUILT.dwg
Plot Time: Thu, 26 Apr 2018 - 9:25am
Model Units: Feet
Login: L.Louie
Xrefs: V:\2963J_Various_Locations_Sewer_Replacement-IV with VI PR No.37 Official Project_TBa DEL TB 22434.dwg
V:\2963J_Various_Locations_Sewer_Replacement-IV with VI PR No.37 V2 Design Working Drawings\CH\2963J_SW1 18th - Arkansas t
V:\2963J_Various_Locations_Sewer_Replacement-IV with VI PR No.37 V2 Design Working Drawings\CH\2963J_SW4 Connecticut - 18d
V:\2963J_Various_Locations_Sewer_Replacement-IV with VI PR No.37 V2 Design Working Drawings\CH\2963J_SW5 Connecticut - 19d