
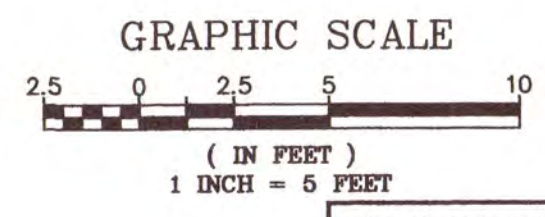


CALIFORNIA ST.

Kennedy/Jenks
Consultants

PRECISION
ENGINEERING
1939 NEWCOMB AVENUE
SAN FRANCISCO, CA 94124
AS BUILT
DRAWINGS
Sign

29TH AVE.

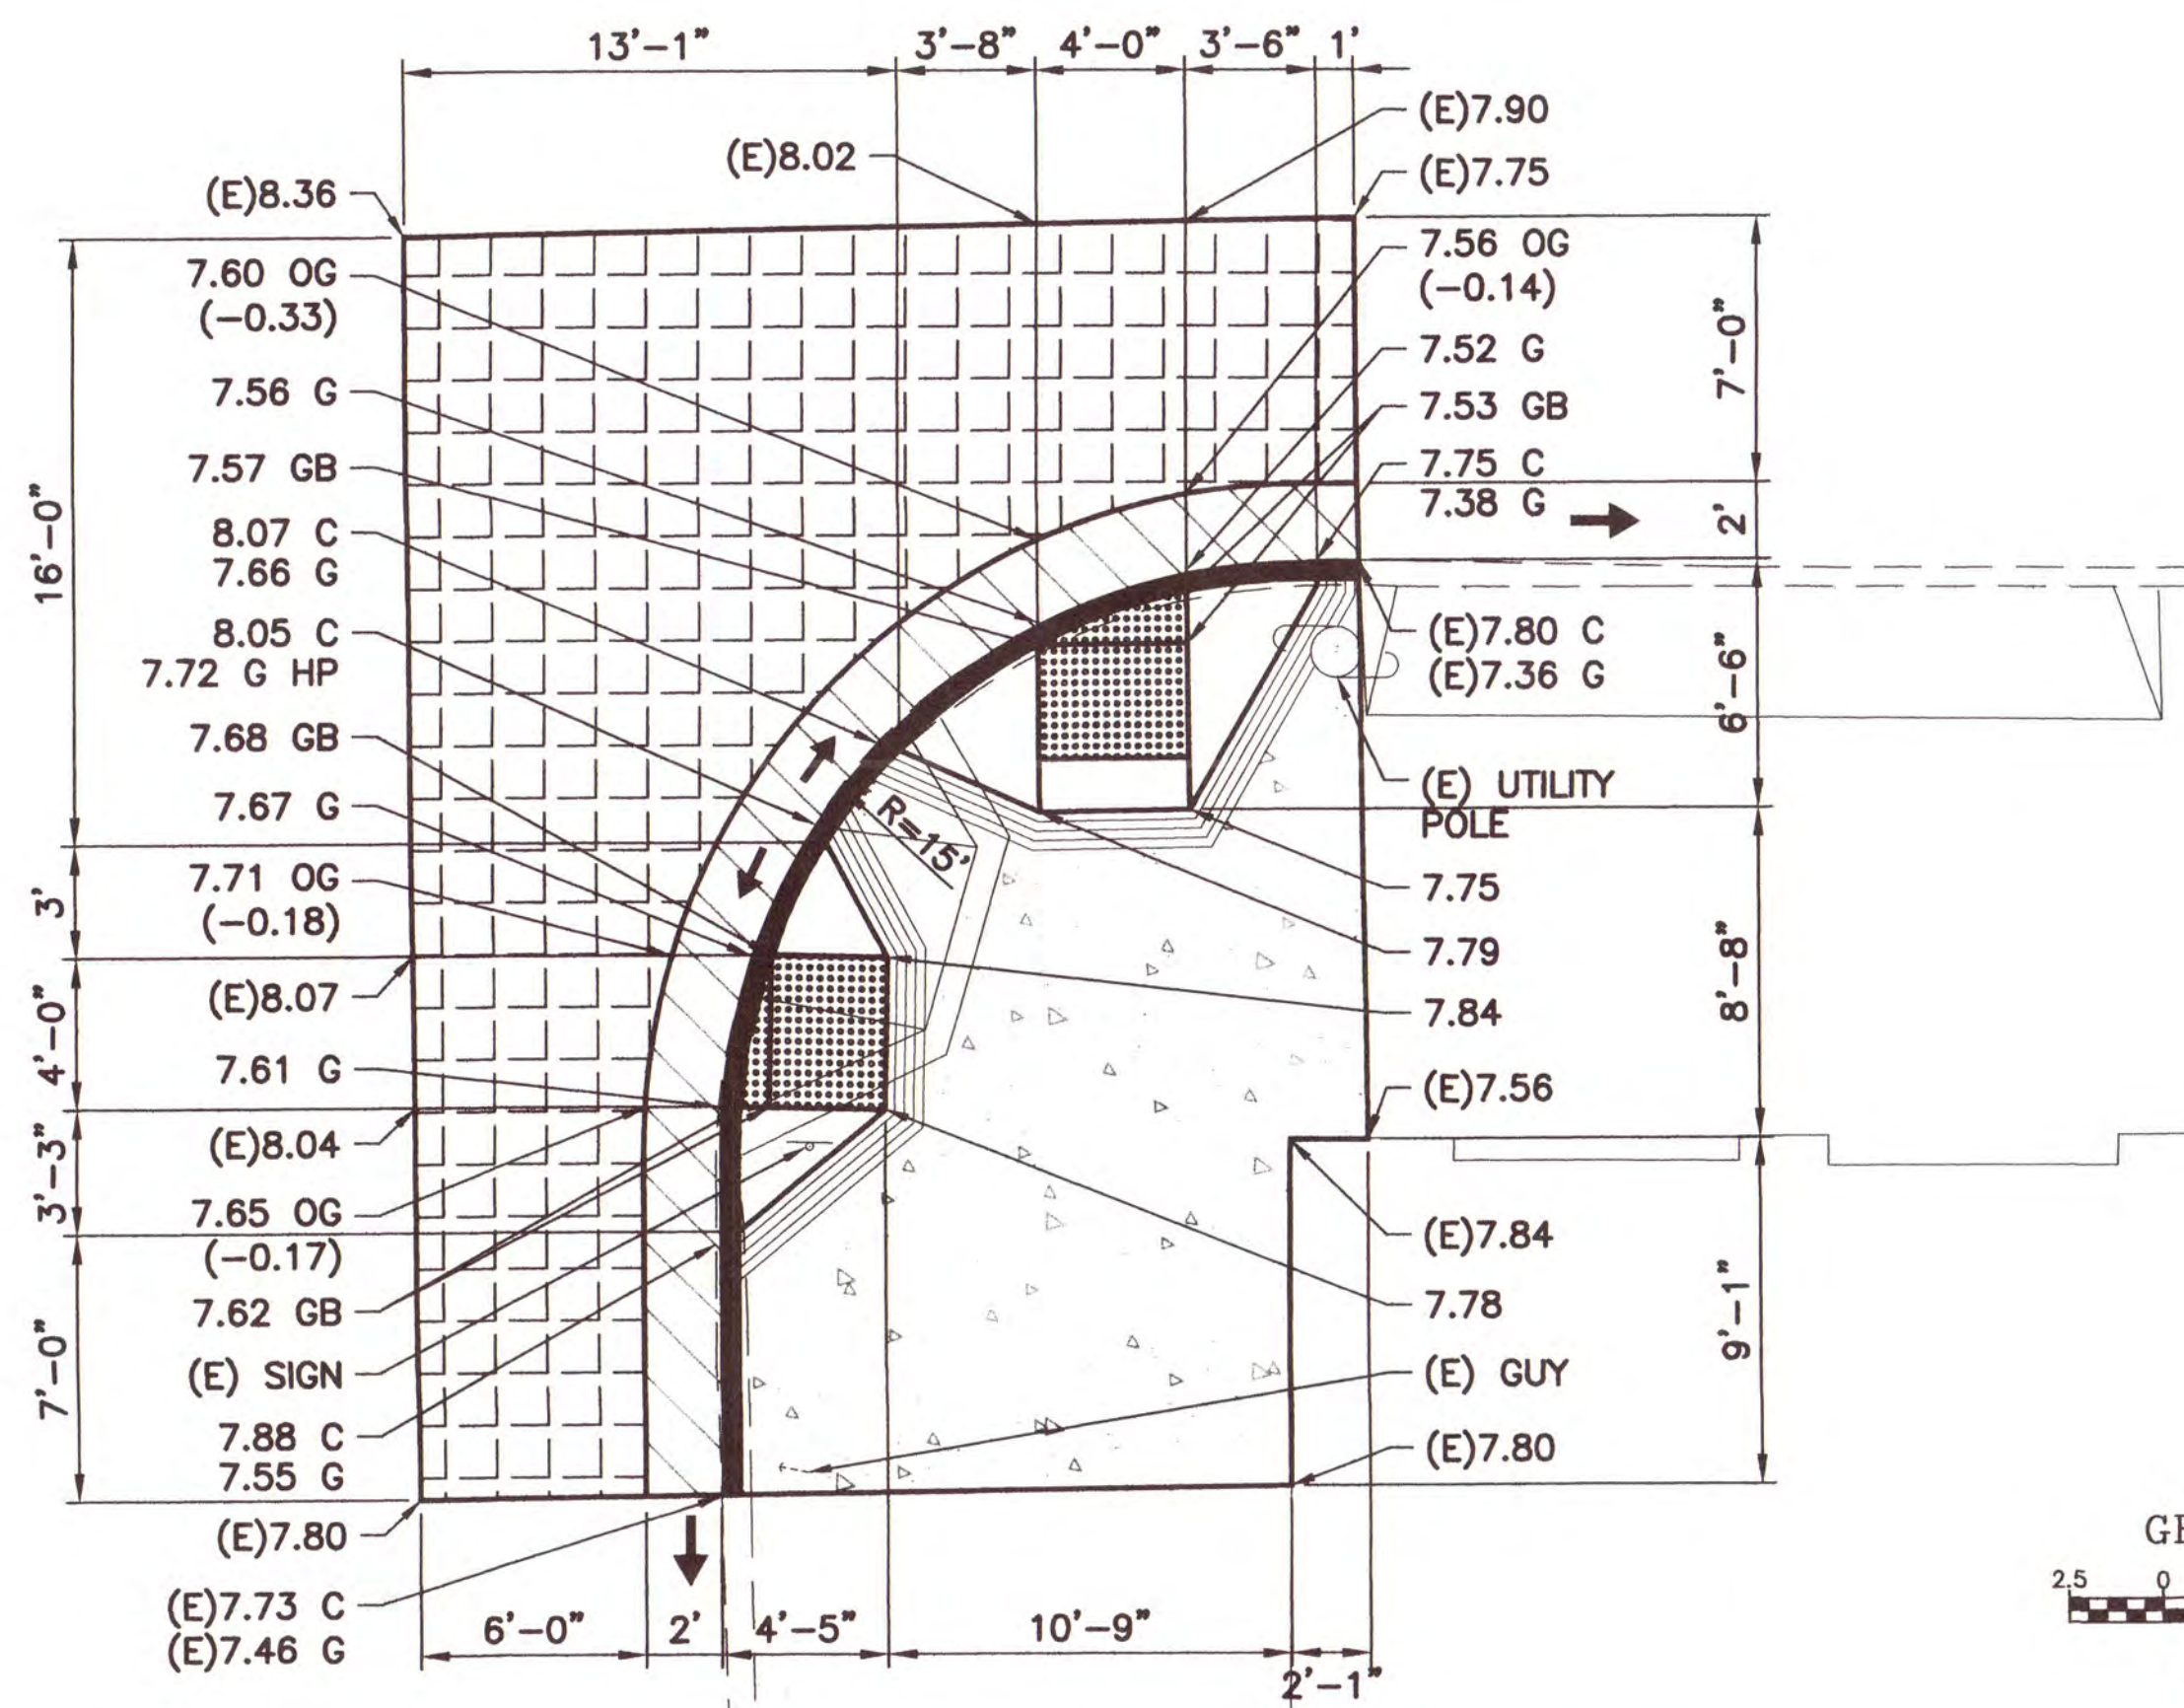

NO.	DATE	DESCRIPTION	BY	APP.
1	03/14/18	TABLE OF REVISIONS	royce	
2				
3				
4				
5				
6				
7				
8				
9				

REFERENCE INFORMATION
& FILE NO. OF SURVEYS



PUBLIC WORKS
DESIGN & ENGINEERING
CITY & COUNTY OF SAN FRANCISCO
30 VAN NESS AVENUE, 5TH FLOOR
SAN FRANCISCO, CA 94102 - 6028

Section Mgr:	Eric T. Kibler	Date:	5/16/18
Deputy Division Mgr:	Paul Lin	Date:	5/16/18
Division Mgr:	Paul Lin	Date:	5/16/18

DESIGNED:	DATE:
TBM	10/28/16
DRAWN:	DATE:
ROO	12/7/16
CHECKED:	DATE:
FCN	12/7/16



SCALE:
1"=5'
SHEET OF SHEETS
44 OF 89

VARIOUS LOCATIONS PAVEMENT
RENOVATION NO. 37 AND SEWER REPLACEMENT
CALIFORNIA STREET AND 29TH AVENUE
CURB RAMP DETAILS

CONTRACT NO.	2792J
DRAWING NO.	CR-20
FILE NO.	109,982
REV. NO.	

Drawing Path: N:\2015\15680017 - Curb Ramps 2792J.dwg
Plot Time: Wed, 14 Mar 2018 - 12:36pm
Xref: X:\Topo-California & 29th.dwg
N:\2015\15680017 - Curb Ramps 2792J.dwg
Various No. 31\DE1_TB_2234_2792J.dwg
Model Units: Undefined