


A B C D E F G H I J K L M N O P




CURB RAMPS(E) TO REMAIN

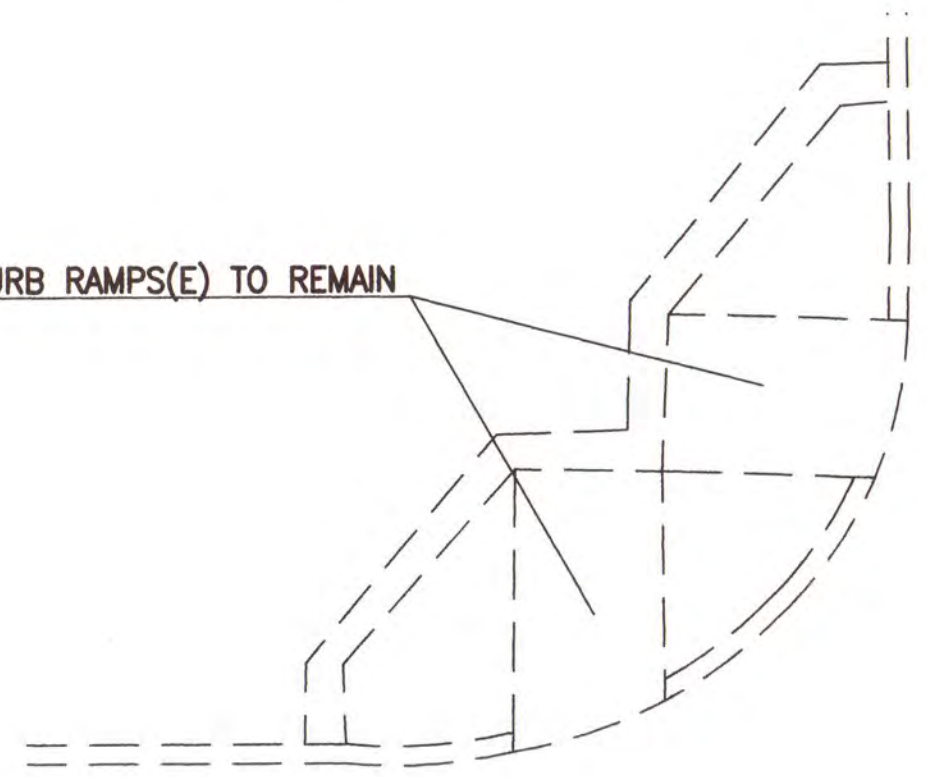

WV

CURB RAMPS(E) TO REMAIN

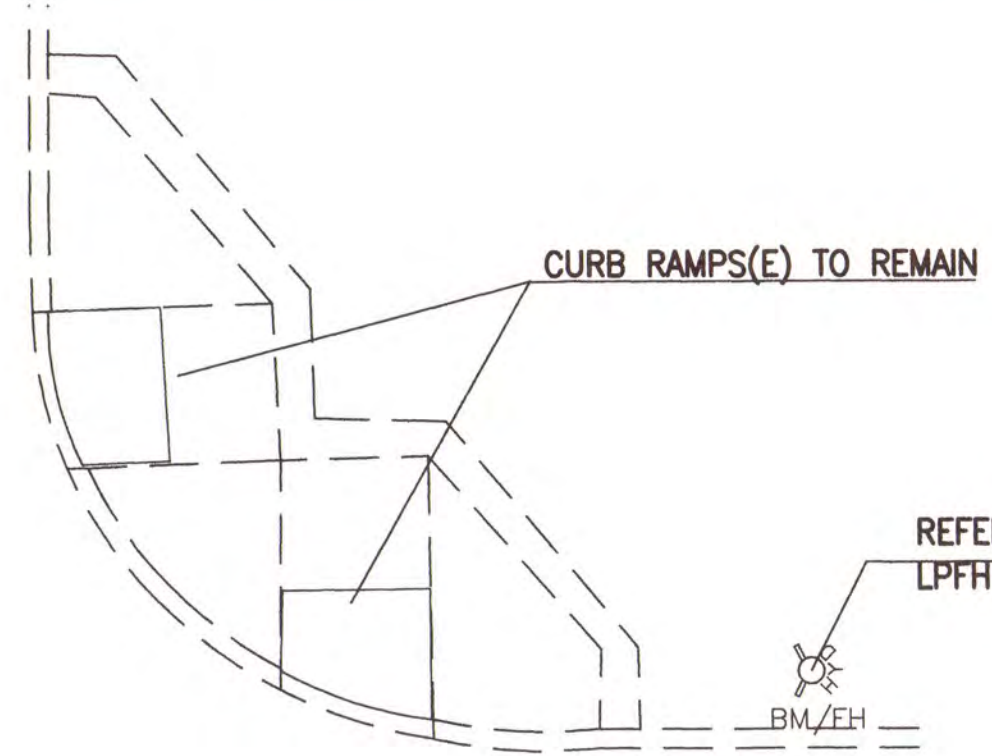

REFERENCE POINT TOP OF LPFH (EL.=10.00)


BM/EL

NOTES:

1. TOPOGRAPHIC SURVEY PERFORMED BY TELAMON ENGINEERING CONSULTANTS, INC. IN NOVEMBER, 2016 USING AN ASSUMED HORIZONTAL AND VERTICAL DATUM, SEE REFERENCE POINT ON TOP OF LPFH (EL.=10.00).
2. PROPERTY LINE IS APPROXIMATE AND BASED ON THE LATEST GRADE MAP INFORMATION OBTAINED FROM THE CITY & COUNTY OF SAN FRANCISCO DEPARTMENT OF PUBLIC WORKS (SFPD) WEBSITE: "HTTP://BSM.SFPD.ORG/SUBDIVISION/KEYMAP/".
3. FACE OF CURB RADIUS AS NOTED.
4. ADJUST CB GRATE HORIZONTALLY TO NEW CURB ALIGNMENT.
5. CONTACT DTIS REGARDING FA(E) PRIOR TO CONSTRUCTION.

VERMONT STREET

19TH STREET

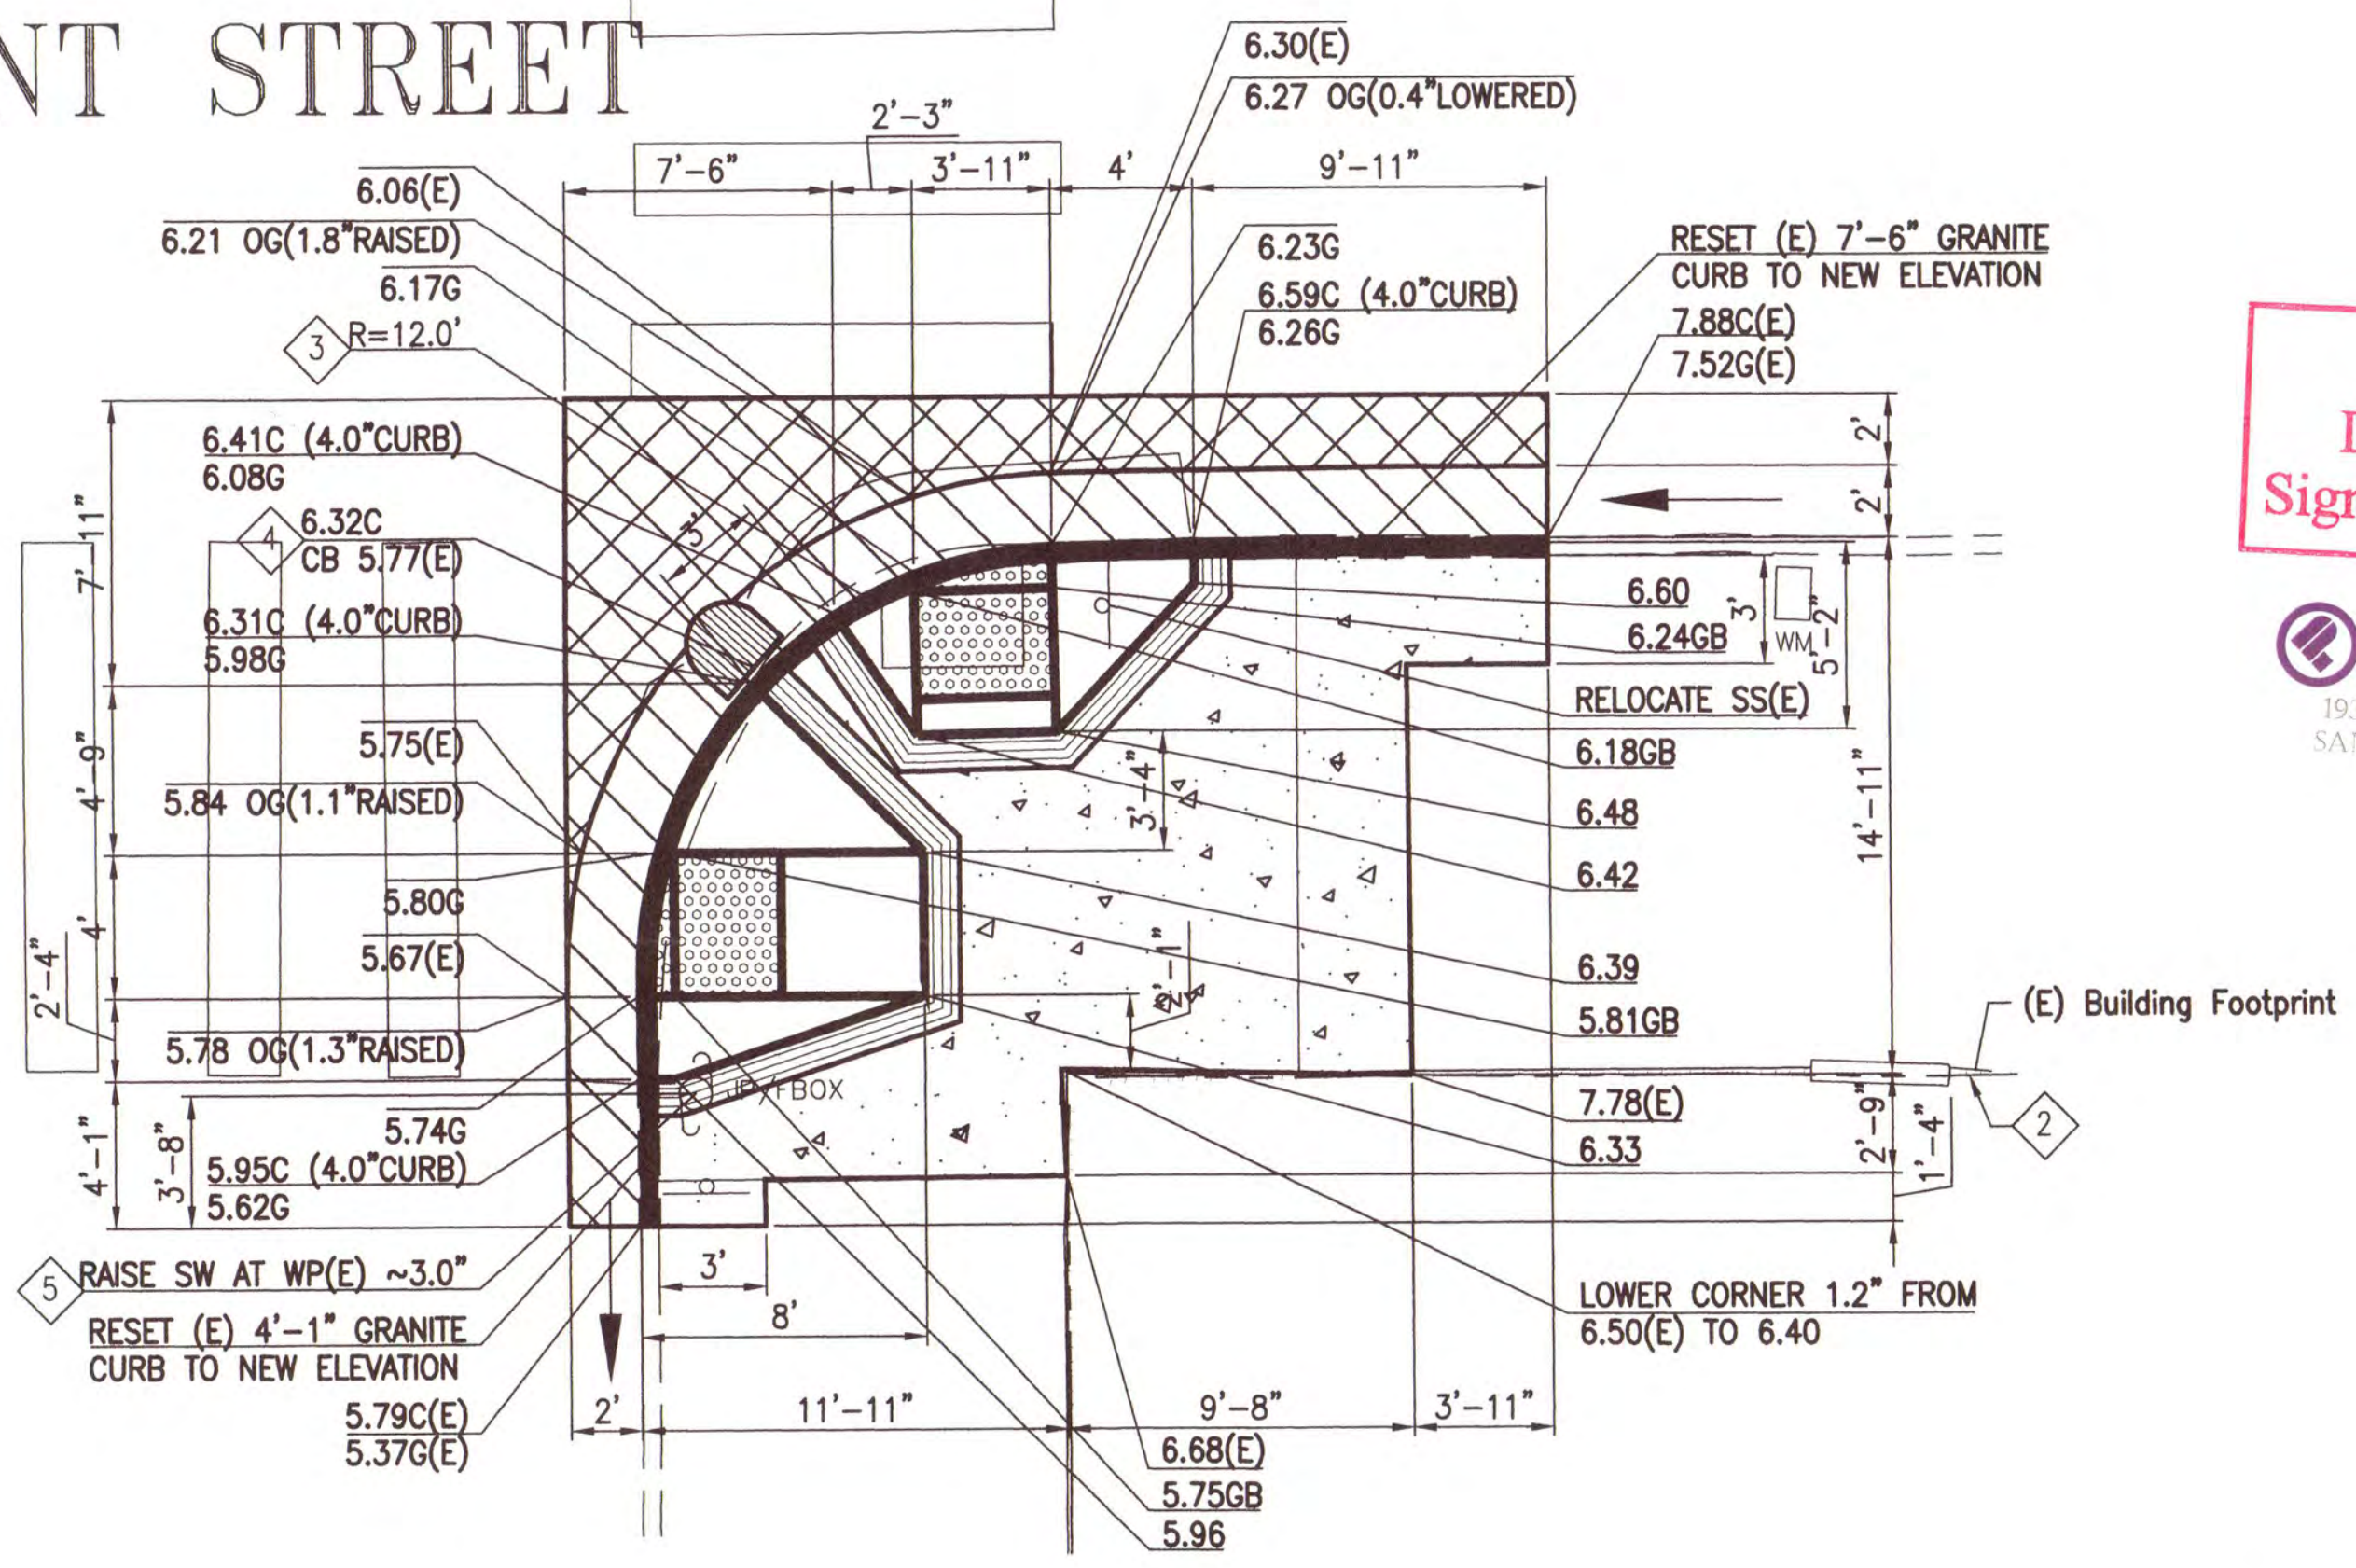

AS BUILT
DRAWINGS
Sign

PRECISION
ENGINEERING
1939 NEWCOMB AVENUE
SAN FRANCISCO, CA 94124


5 0 5 10
SCALE: 1" = 5'

AECOM 300 California Street, Suite 600
San Francisco, Ca 94104
Tel: 415-796-8100
Fax: 415-796-8200

NO.	DATE	DESCRIPTION	BY	APP.

THIS DRAWING WAS LAST MODIFIED: 11/29/17 17:44, BY: joseph.burg


REFERENCE INFORMATION
& FILE NO. OF SURVEYS

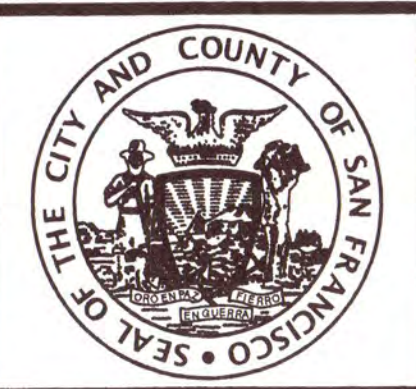

DESIGN & ENGINEERING
CITY & COUNTY OF SAN FRANCISCO
SAN FRANCISCO PUBLIC WORKS
30 VAN NESS AVENUE, 6TH FLOOR
SAN FRANCISCO, CA 94102 - 6028

Section Mgr:	<i>Eric T. Kellberg</i>	Date:	5/16/18
Deputy Division Mgr:	<i>Patricia Rivera</i>	Date:	5/16/18
Division Mgr:	<i>Patricia Rivera</i>	Date:	5/14/18

DESIGNED:	DATE:
A. EHSAN	04/18
DRAWN:	DATE:
B. CARPENTER	04/18
CHECKED:	DATE:
T. SWEET	04/18

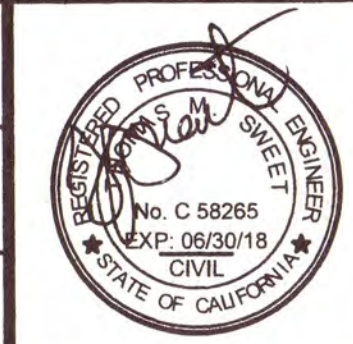

SCALE:
1" = 5'
SHEET OF SHEETS
27 OF 89

VARIOUS LOCATIONS PAVEMENT
RENOVATION NO. 37 AND SEWER REPLACEMENT
VERMONT STREET AND 19TH STREET
CURB RAMP DETAILS

CONTRACT NO.	2792J
DRAWING NO.	CR-04
FILE NO.	109,966
REV. NO.	

Dimension Scale: 5
Model Units: Undefined
Drawing Path: T:\SFPD\Various Locations 37 (2792J)\Sheet\CR-04.dwg, Login: joseph.burg
Plot Time: Mon, 23 Apr 2018 - 7:08pm