



- NOTES:
- TOPOGRAPHIC SURVEY PERFORMED BY TELAMON ENGINEERING CONSULTANTS, INC. IN NOVEMBER, 2016 USING AN ASSUMED HORIZONTAL AND VERTICAL DATUM, SEE REFERENCE POINT ON TOP OF LPFH (EL=10.00).
 - PROPERTY LINE IS APPROXIMATE AND BASED ON THE LATEST GRADE MAP INFORMATION OBTAINED FROM THE CITY & COUNTY OF SAN FRANCISCO DEPARTMENT OF PUBLIC WORKS (SFPDW) WEBSITE: "HTTP://BSM.SFPDW.ORG/SUBDIVISION/KEYMAP/".
 - FACE OF CURB RADIUS AS NOTED.
 - ADJUST CB GRATE HORIZONTALLY TO NEW CURB ALIGNMENT.

KANSAS STREET

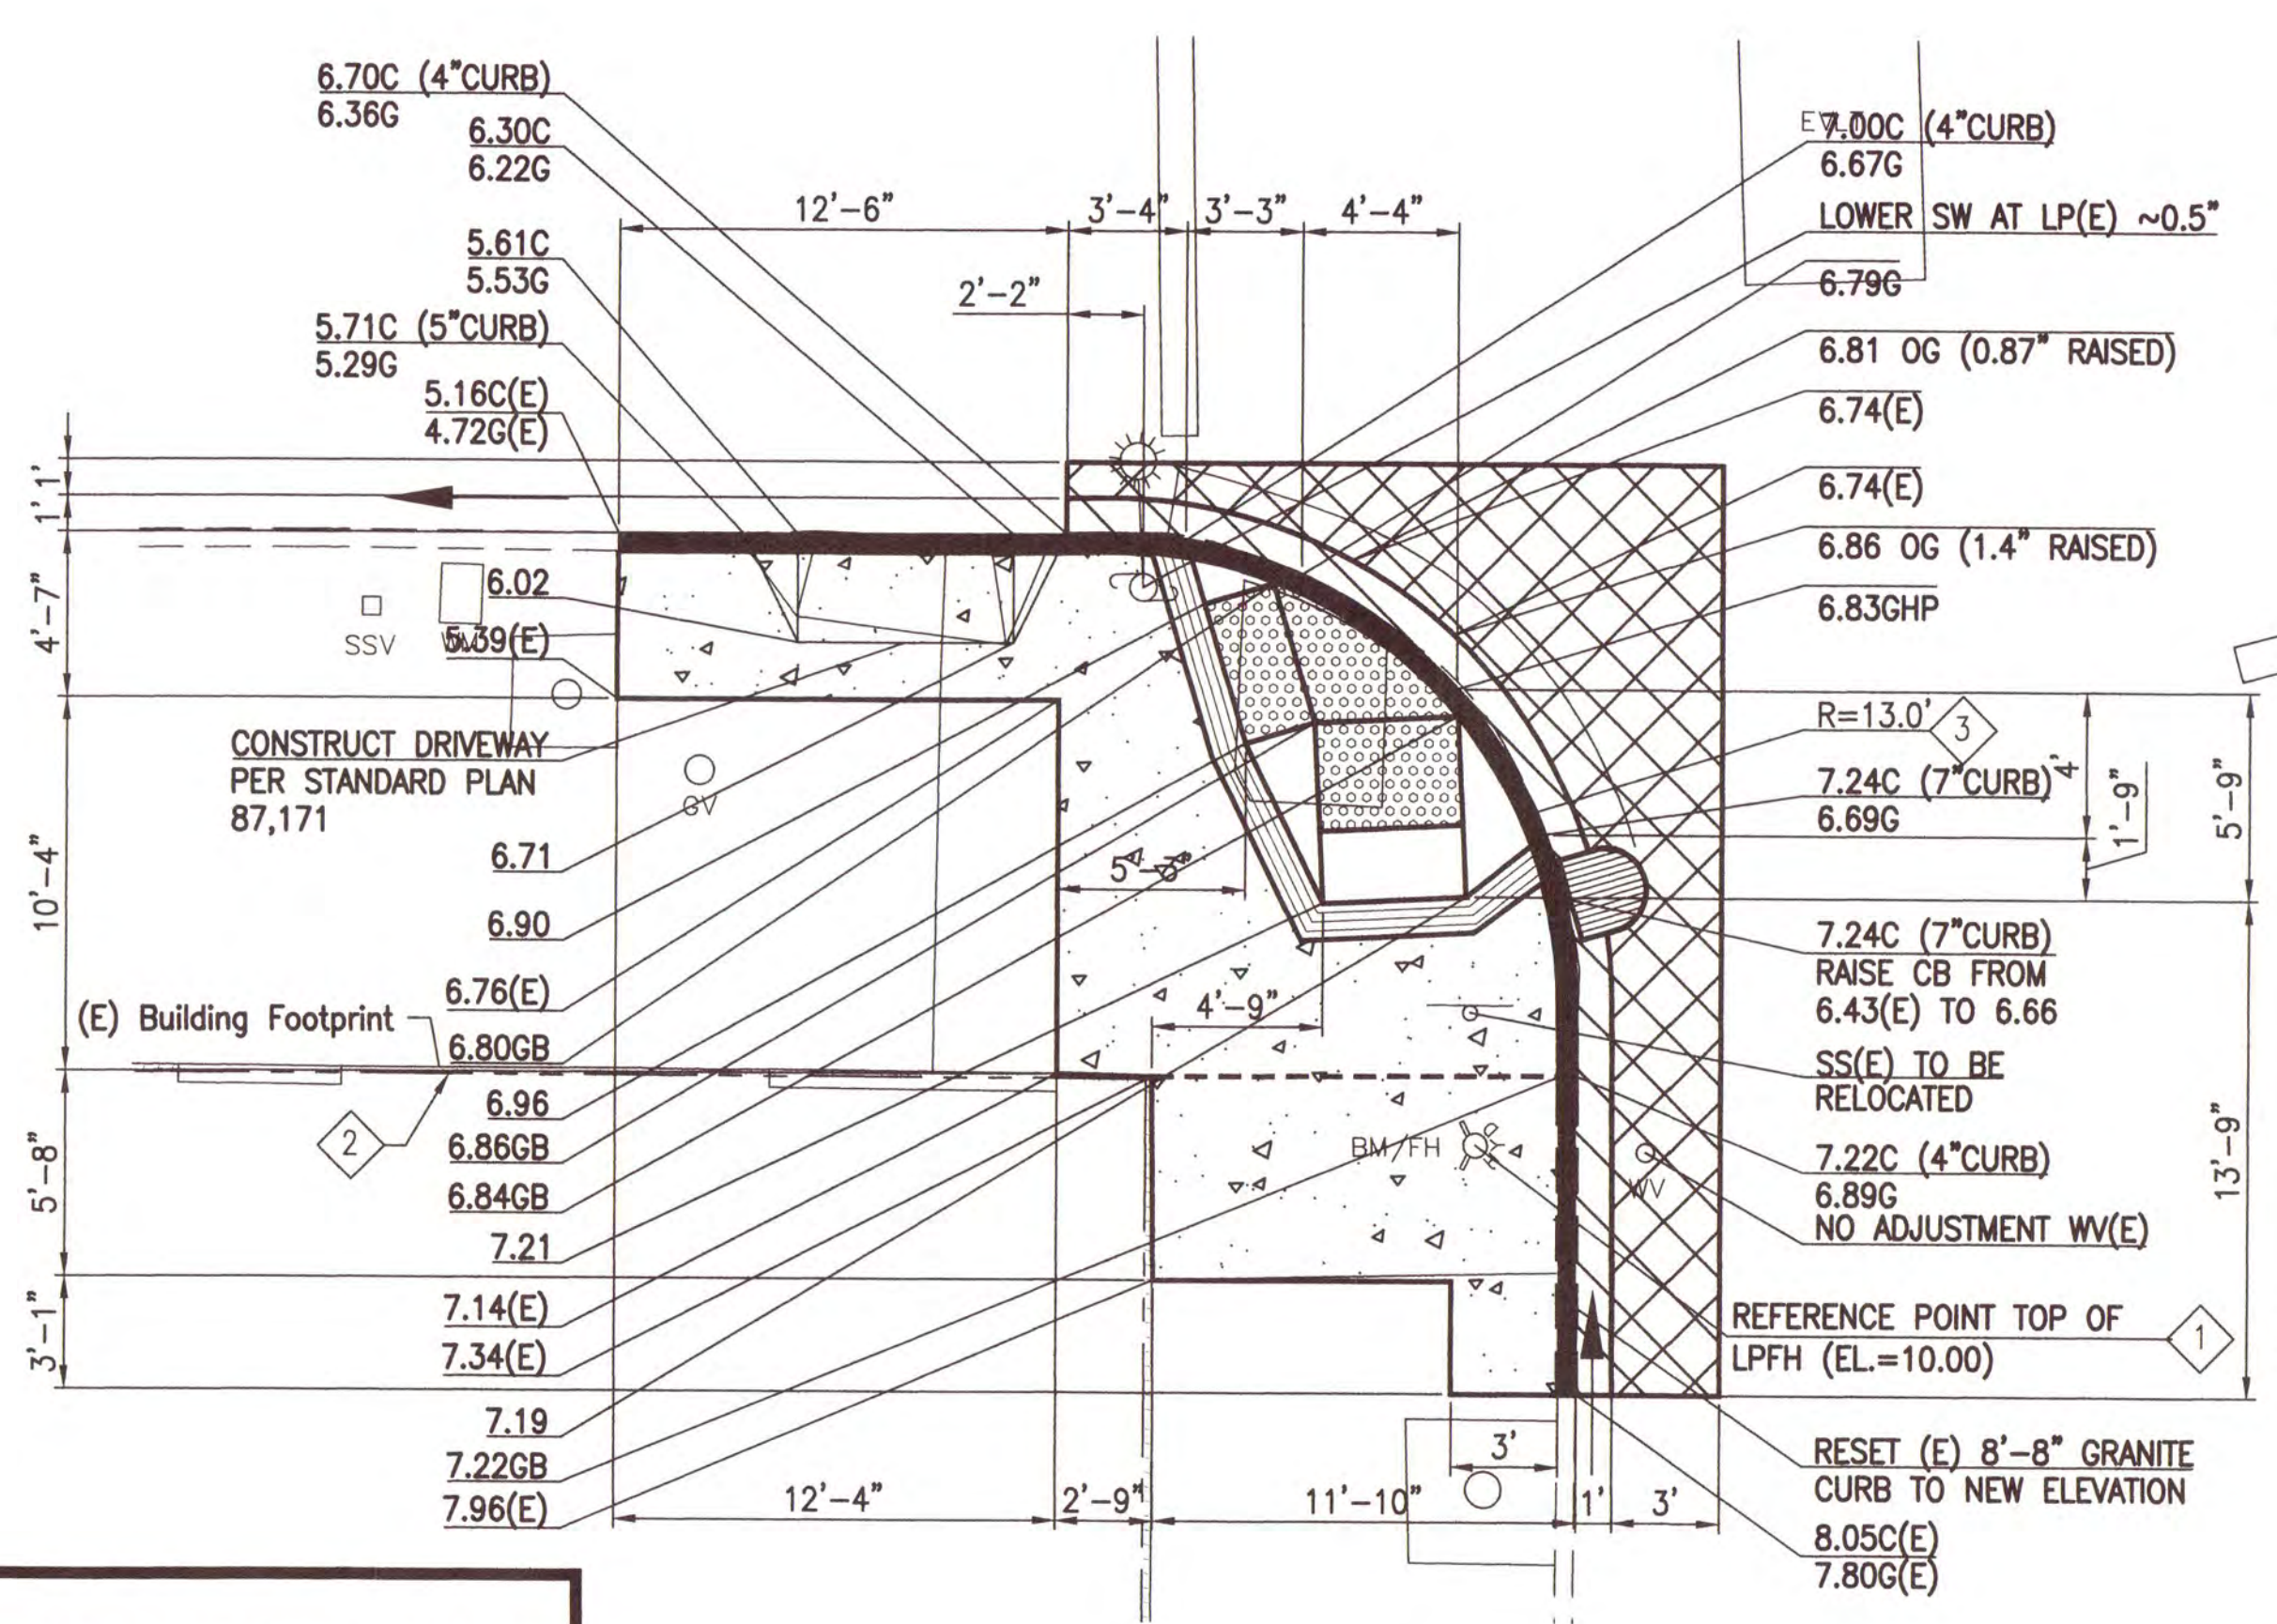

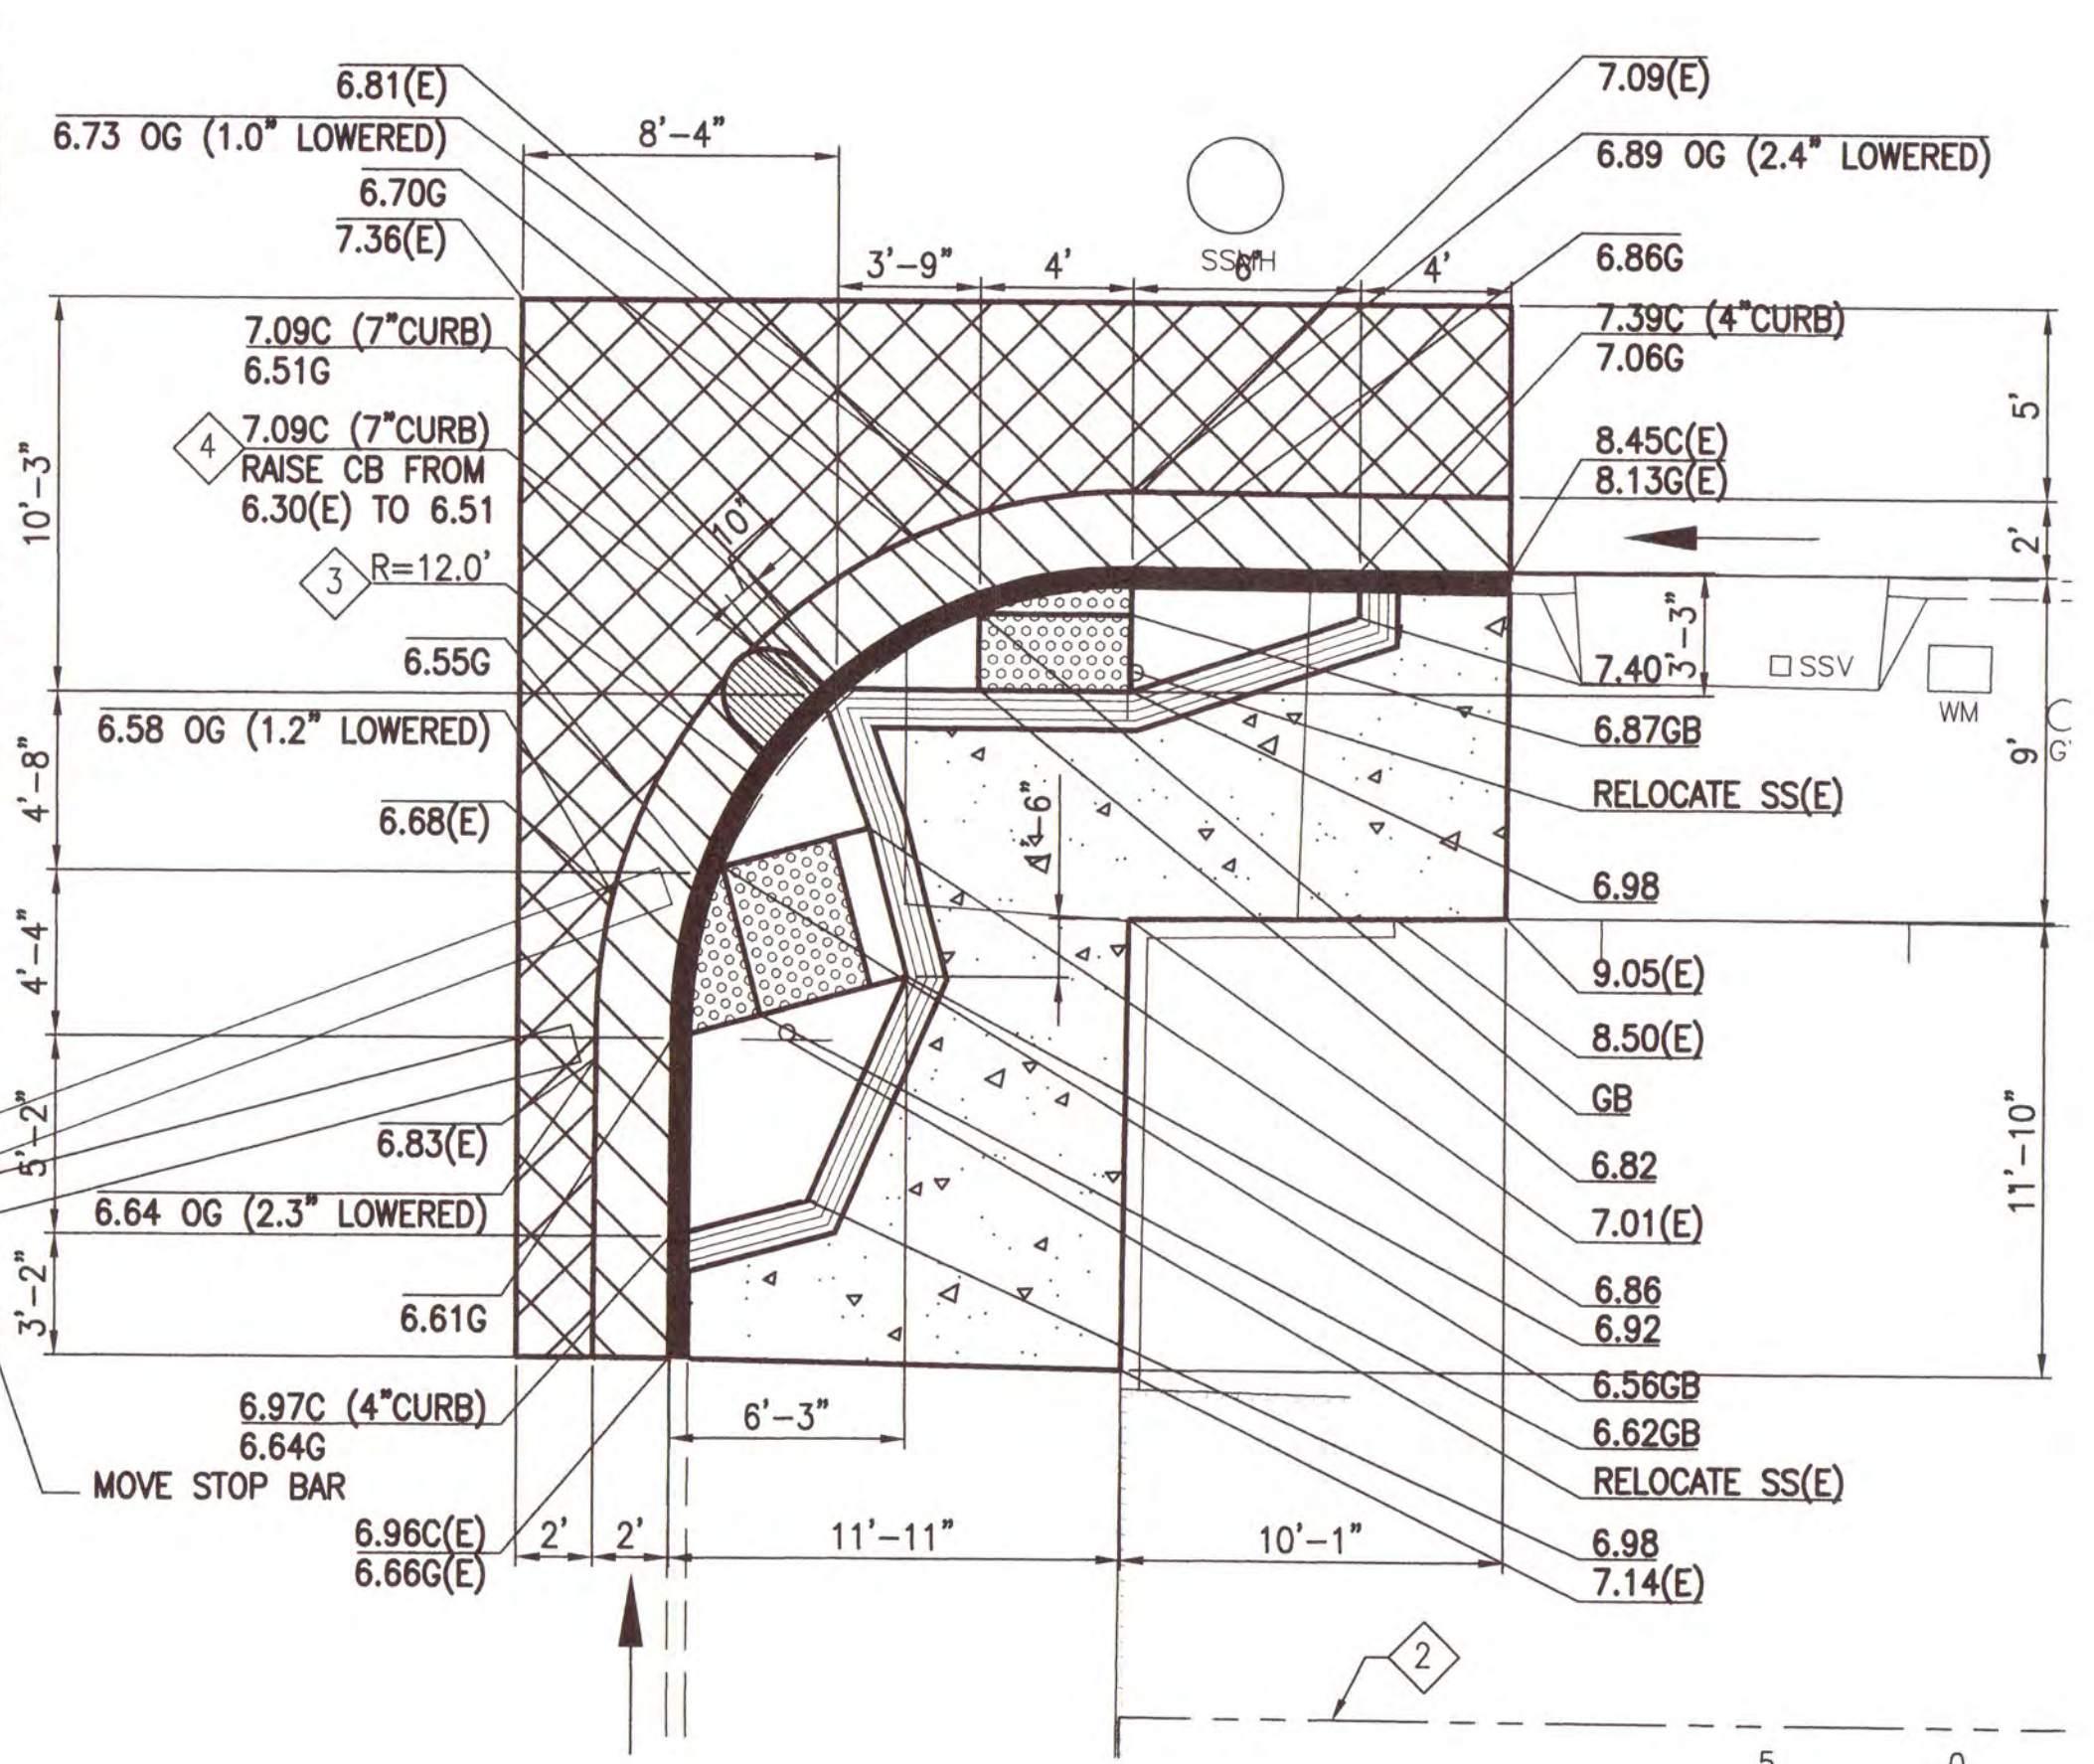


MARIPOSA STREET



AS BUILT
DRAWINGS
Sign *[Signature]*



300 California Street, Suite 600
San Francisco, Ca 94104
Tel: 415-796-8100
Fax: 415-796-8200

					REFERENCE INFORMATION & FILE NO. OF SURVEYS				 DESIGN & ENGINEERING CITY & COUNTY OF SAN FRANCISCO SAN FRANCISCO PUBLIC WORKS 30 VAN NESS AVENUE, 5TH FLOOR SAN FRANCISCO, CA 94102 - 6028		Section Mgr: <i>Eric T. Kibburg</i> Date: 5/16/18		DESIGNED: DATE: A. EHS AEI 4/18				SCALE: 1" = 5'		VARIOUS LOCATIONS PAVEMENT RENOVATION NO. 37 AND SEWER REPLACEMENT		EHY JO NO. 2963J	
											Deputy Division Mgr: <i>Paul J. Klein</i> Date: 5/16/18		DRAWN: DATE: B. CARPENTER 04/18						CONTRACT NO. 2792J			
											Division Mgr: <i>Patrick Rivera</i> Date: 5/16/18		CHECKED: DATE: T. SWEET 4/18						DRAWING NO. CR-06			
NO. DATE DESCRIPTION BY APP.																			FILE NO. 109,968			
TABLE OF REVISIONS																			REV. NO.			
THIS DRAWING WAS LAST MODIFIED: 11/29/17 17:46, BY: joseph.burg																						

Xrefs: T:\SFPDW Various Locations 37 (2792J)\Plan\XC-2792J-BOE Title Block.dwg
T:\SFPDW Various Locations 37 (2792J)\Plan\XC-TOPO KANSAS AND MARIPOSA.dwg
T:\SFPDW Various Locations 37 (2792J)\Plan\XC-DESIGN KANSAS AND MARIPOSA.dwg
Dimension Scale: 5
Model Units: Undefined
Drawing Path: T:\SFPDW Various Locations 37 (2792J)\Sheet\CR-06.dwg, Login: joseph.burg
Plot Time: Mon, 23 Apr 2018 - 7:09pm