


- NOTES:
- BULB-OUT CONSTRUCTED UNDER 3239V - GUY PL MINI PARK. ELEVATIONS MATCH CONFORM LIMITS.

PRECISION
ENGINEERING
1939 NEWCOMB AVENUE
SAN FRANCISCO, CA 94124

**AS BUILT
DRAWINGS**
Sign *[Signature]*

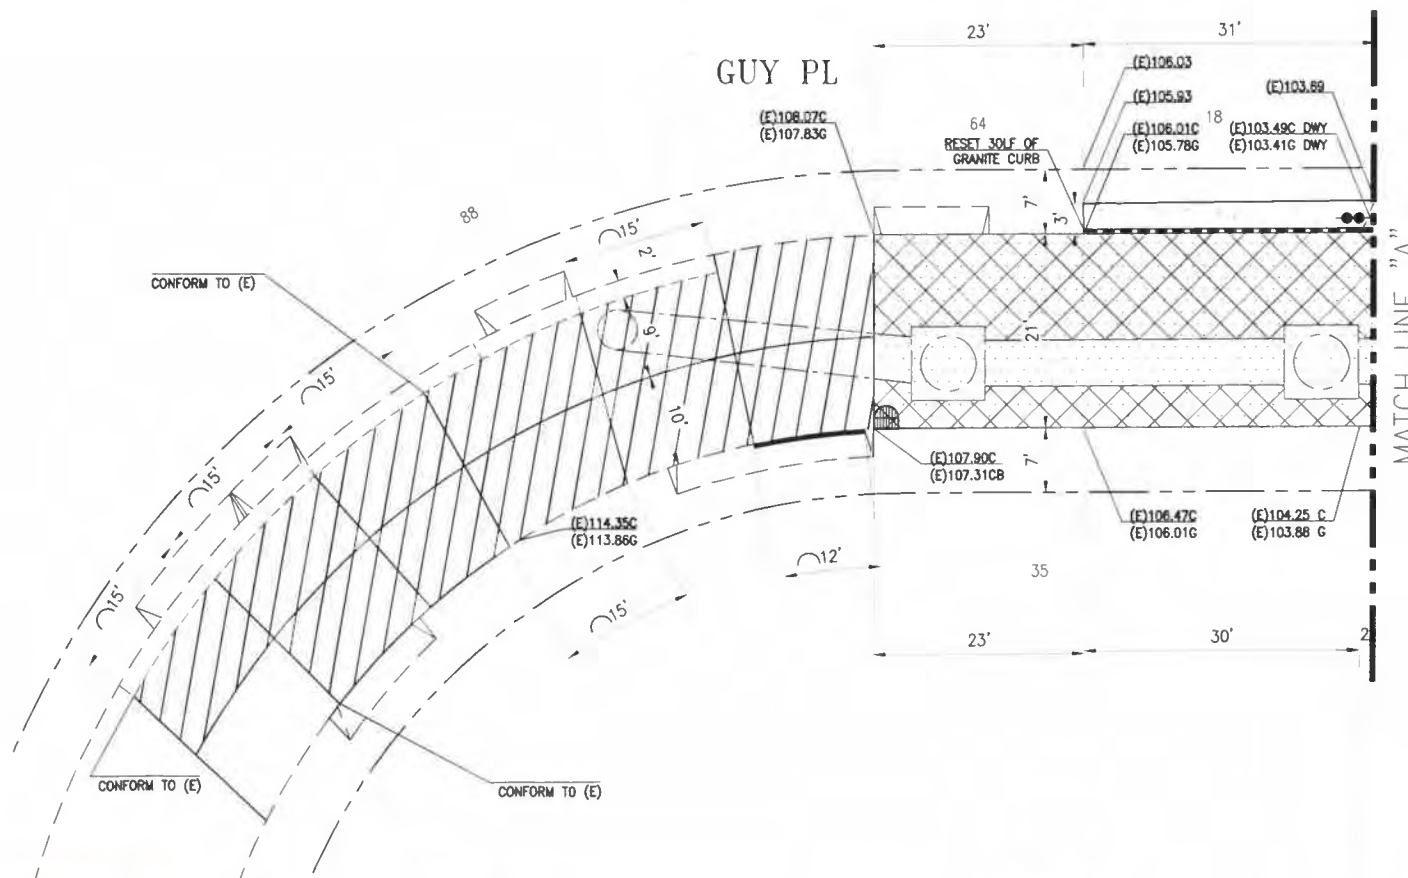

10 0 10 20
HORIZONTAL SCALE IN FEET

NO.	DATE	DESCRIPTION	BY	APP.
TABLE OF REVISIONS				
THIS DRAWING WAS LAST MODIFIED: 04/15/20 16:52, BY: louie				

REFERENCE INFORMATION
& FILE NO. OF SURVEYS



BUREAU OF ENGINEERING
CITY & COUNTY OF SAN FRANCISCO
SAN FRANCISCO PUBLIC WORKS
30 VAY NISS AVENUE 5TH FLOOR
SAN FRANCISCO, CA 94102 - 6028

Acting Section Mgr	ERIC KJELSBORG	Date	04/16/2020
Deputy Bureau Mgr	FERRI (A) DO CISHNEROS	Date	04/16/2020
Acting Bureau Mgr	IQBAL DHABA	Date	04/16/2020
DESIGNED	DATE	DRAWN	DATE
L.LOUIE	03/20	L.LOUIE	03/20
CHECKED	DATE	D.CHAN	04/20



SCALE:
1" = 10'
SHEET OF SHEETS
6.1 OF 89

VARIOUS LOCATIONS PAVEMENT
RENOVATION NO. 37 AND SEWER REPLACEMENT
GRADING PLAN
GUY PL
LANSING ST TO 1ST ST

CONTRACT NO.	2792J
DRAWING NO.	R-1.1
FILE NO.	109,945.1
REV. NO.	0