




CALIFORNIA ST.

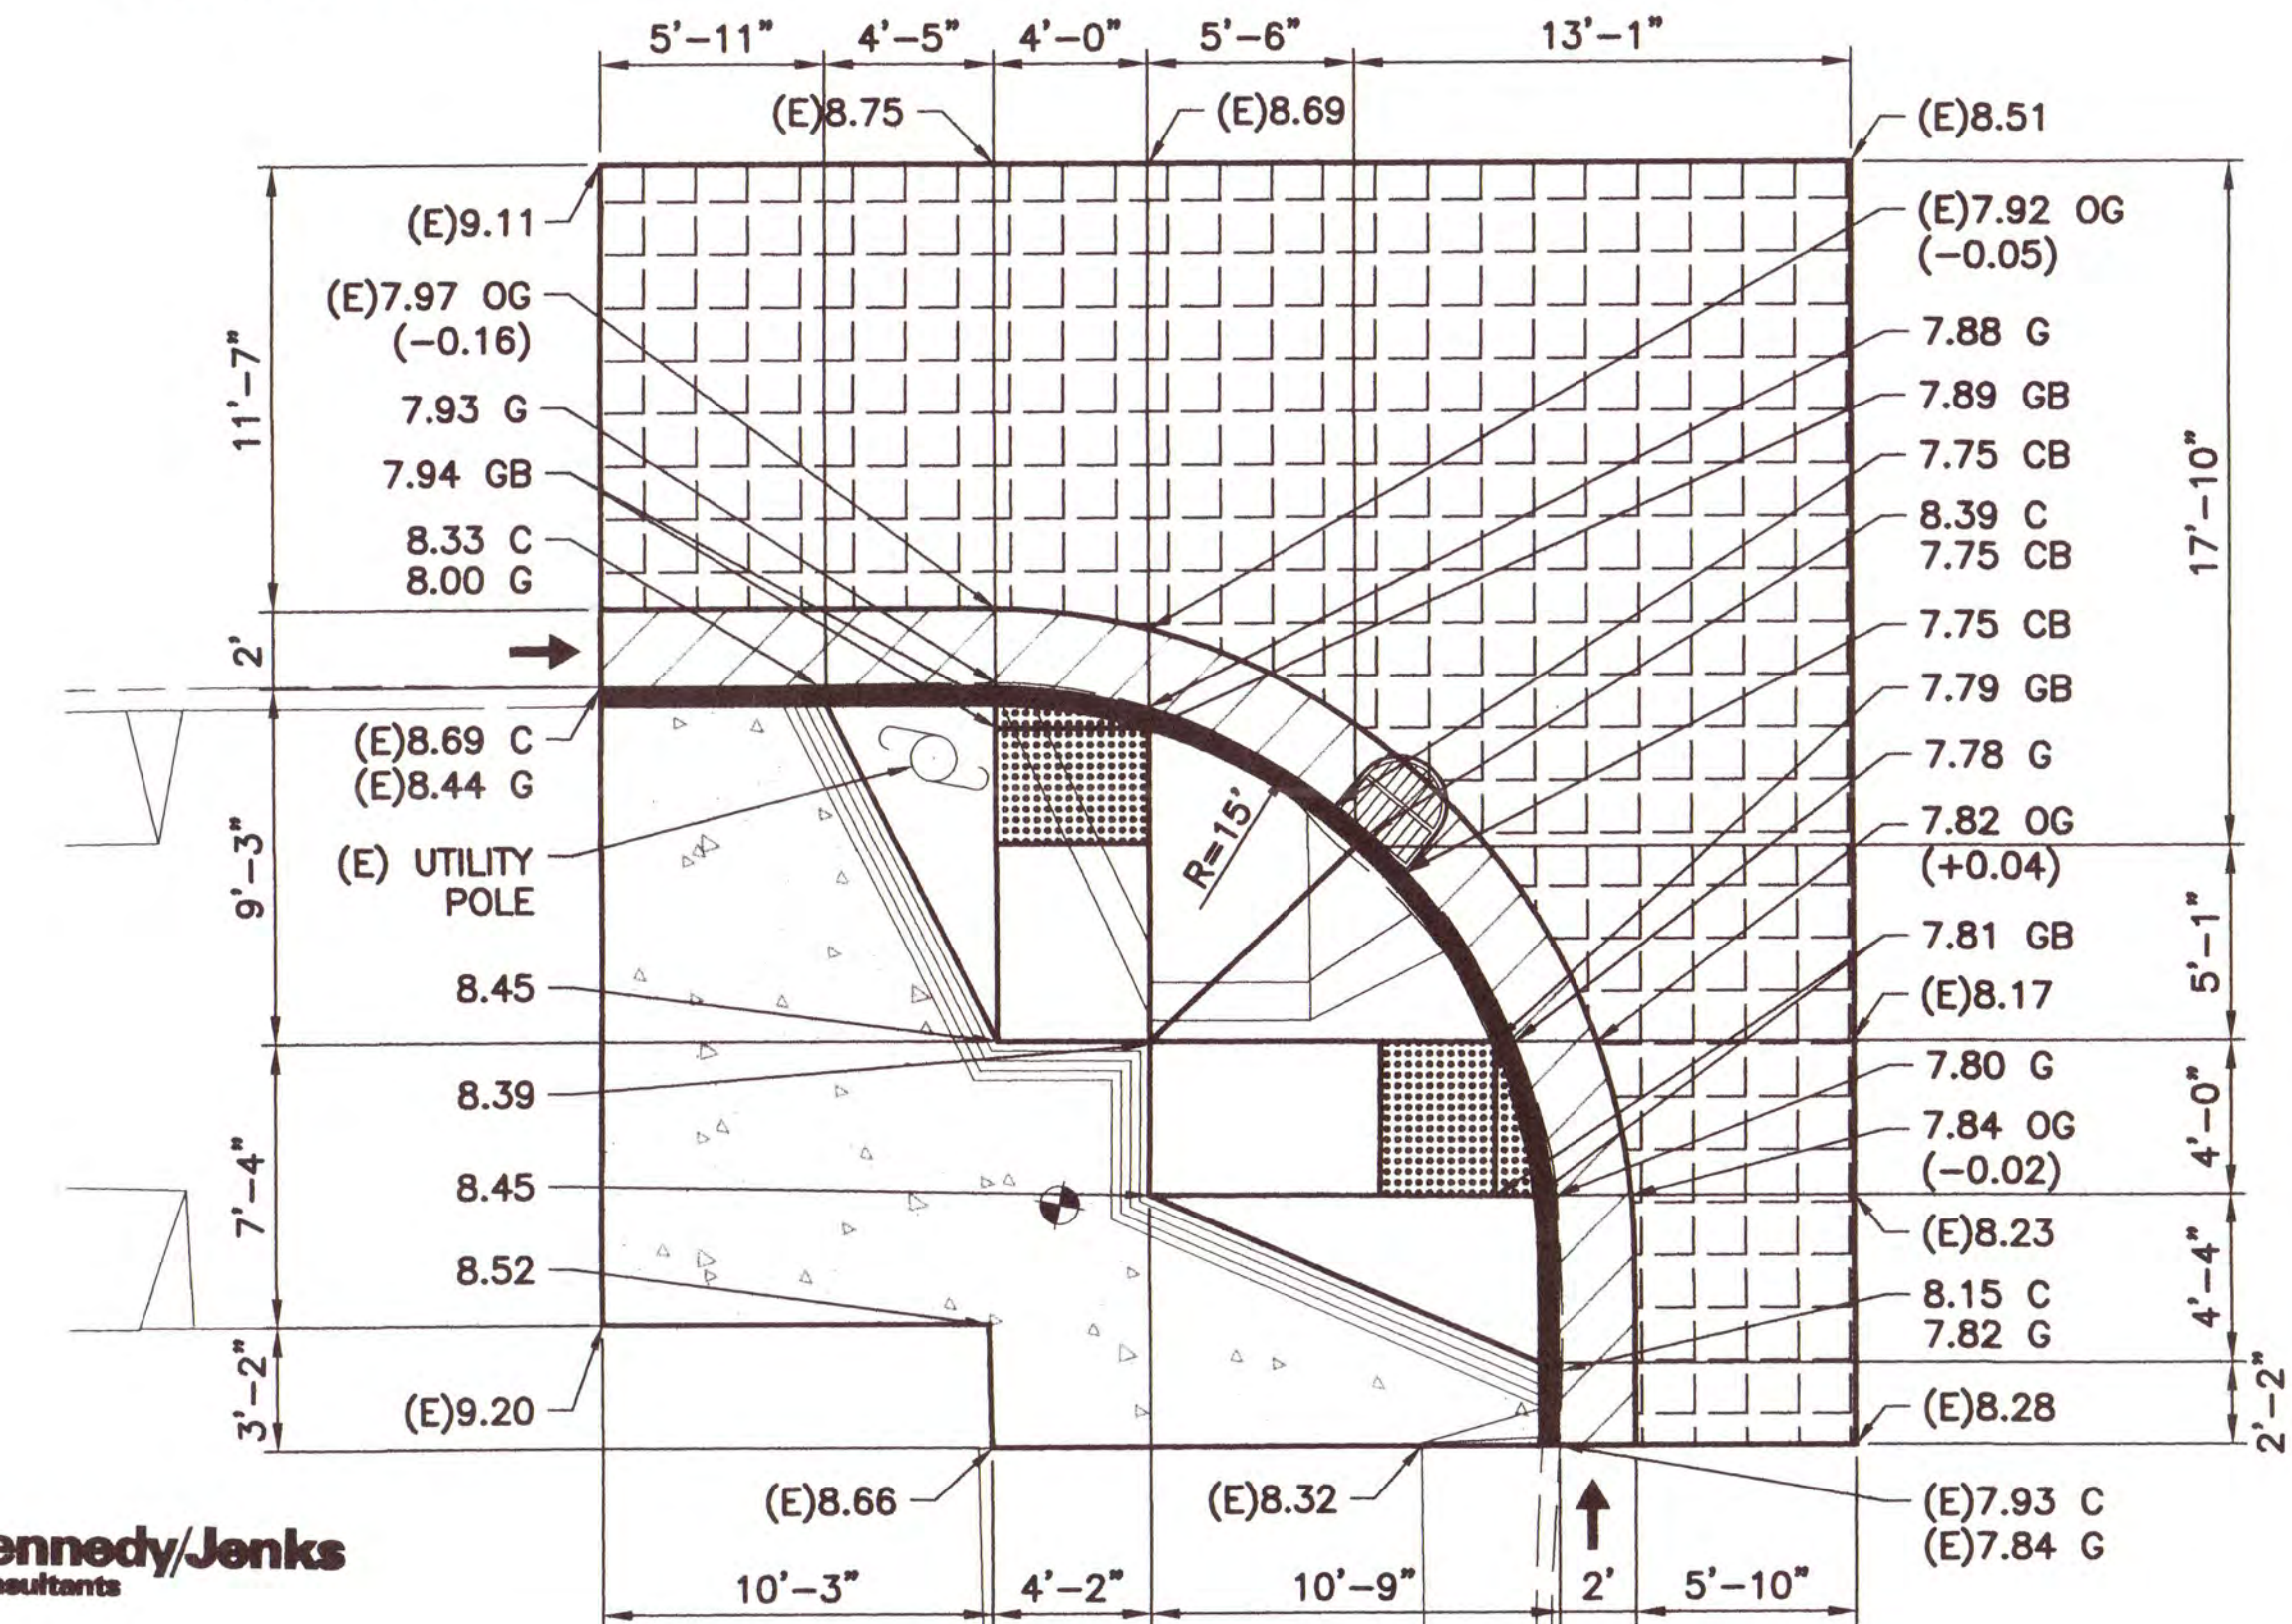

PRECISION  
ENGINEERING  
1939 NEWCOMB AVENUE  
SAN FRANCISCO, CA 94124


AS BUILT  
DRAWINGS  
Sign *[Signature]*

31ST AVE.

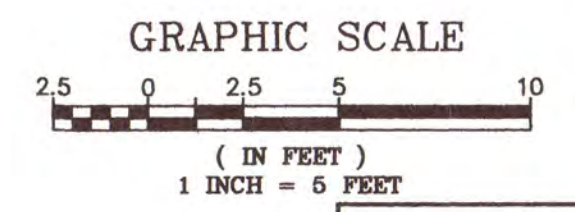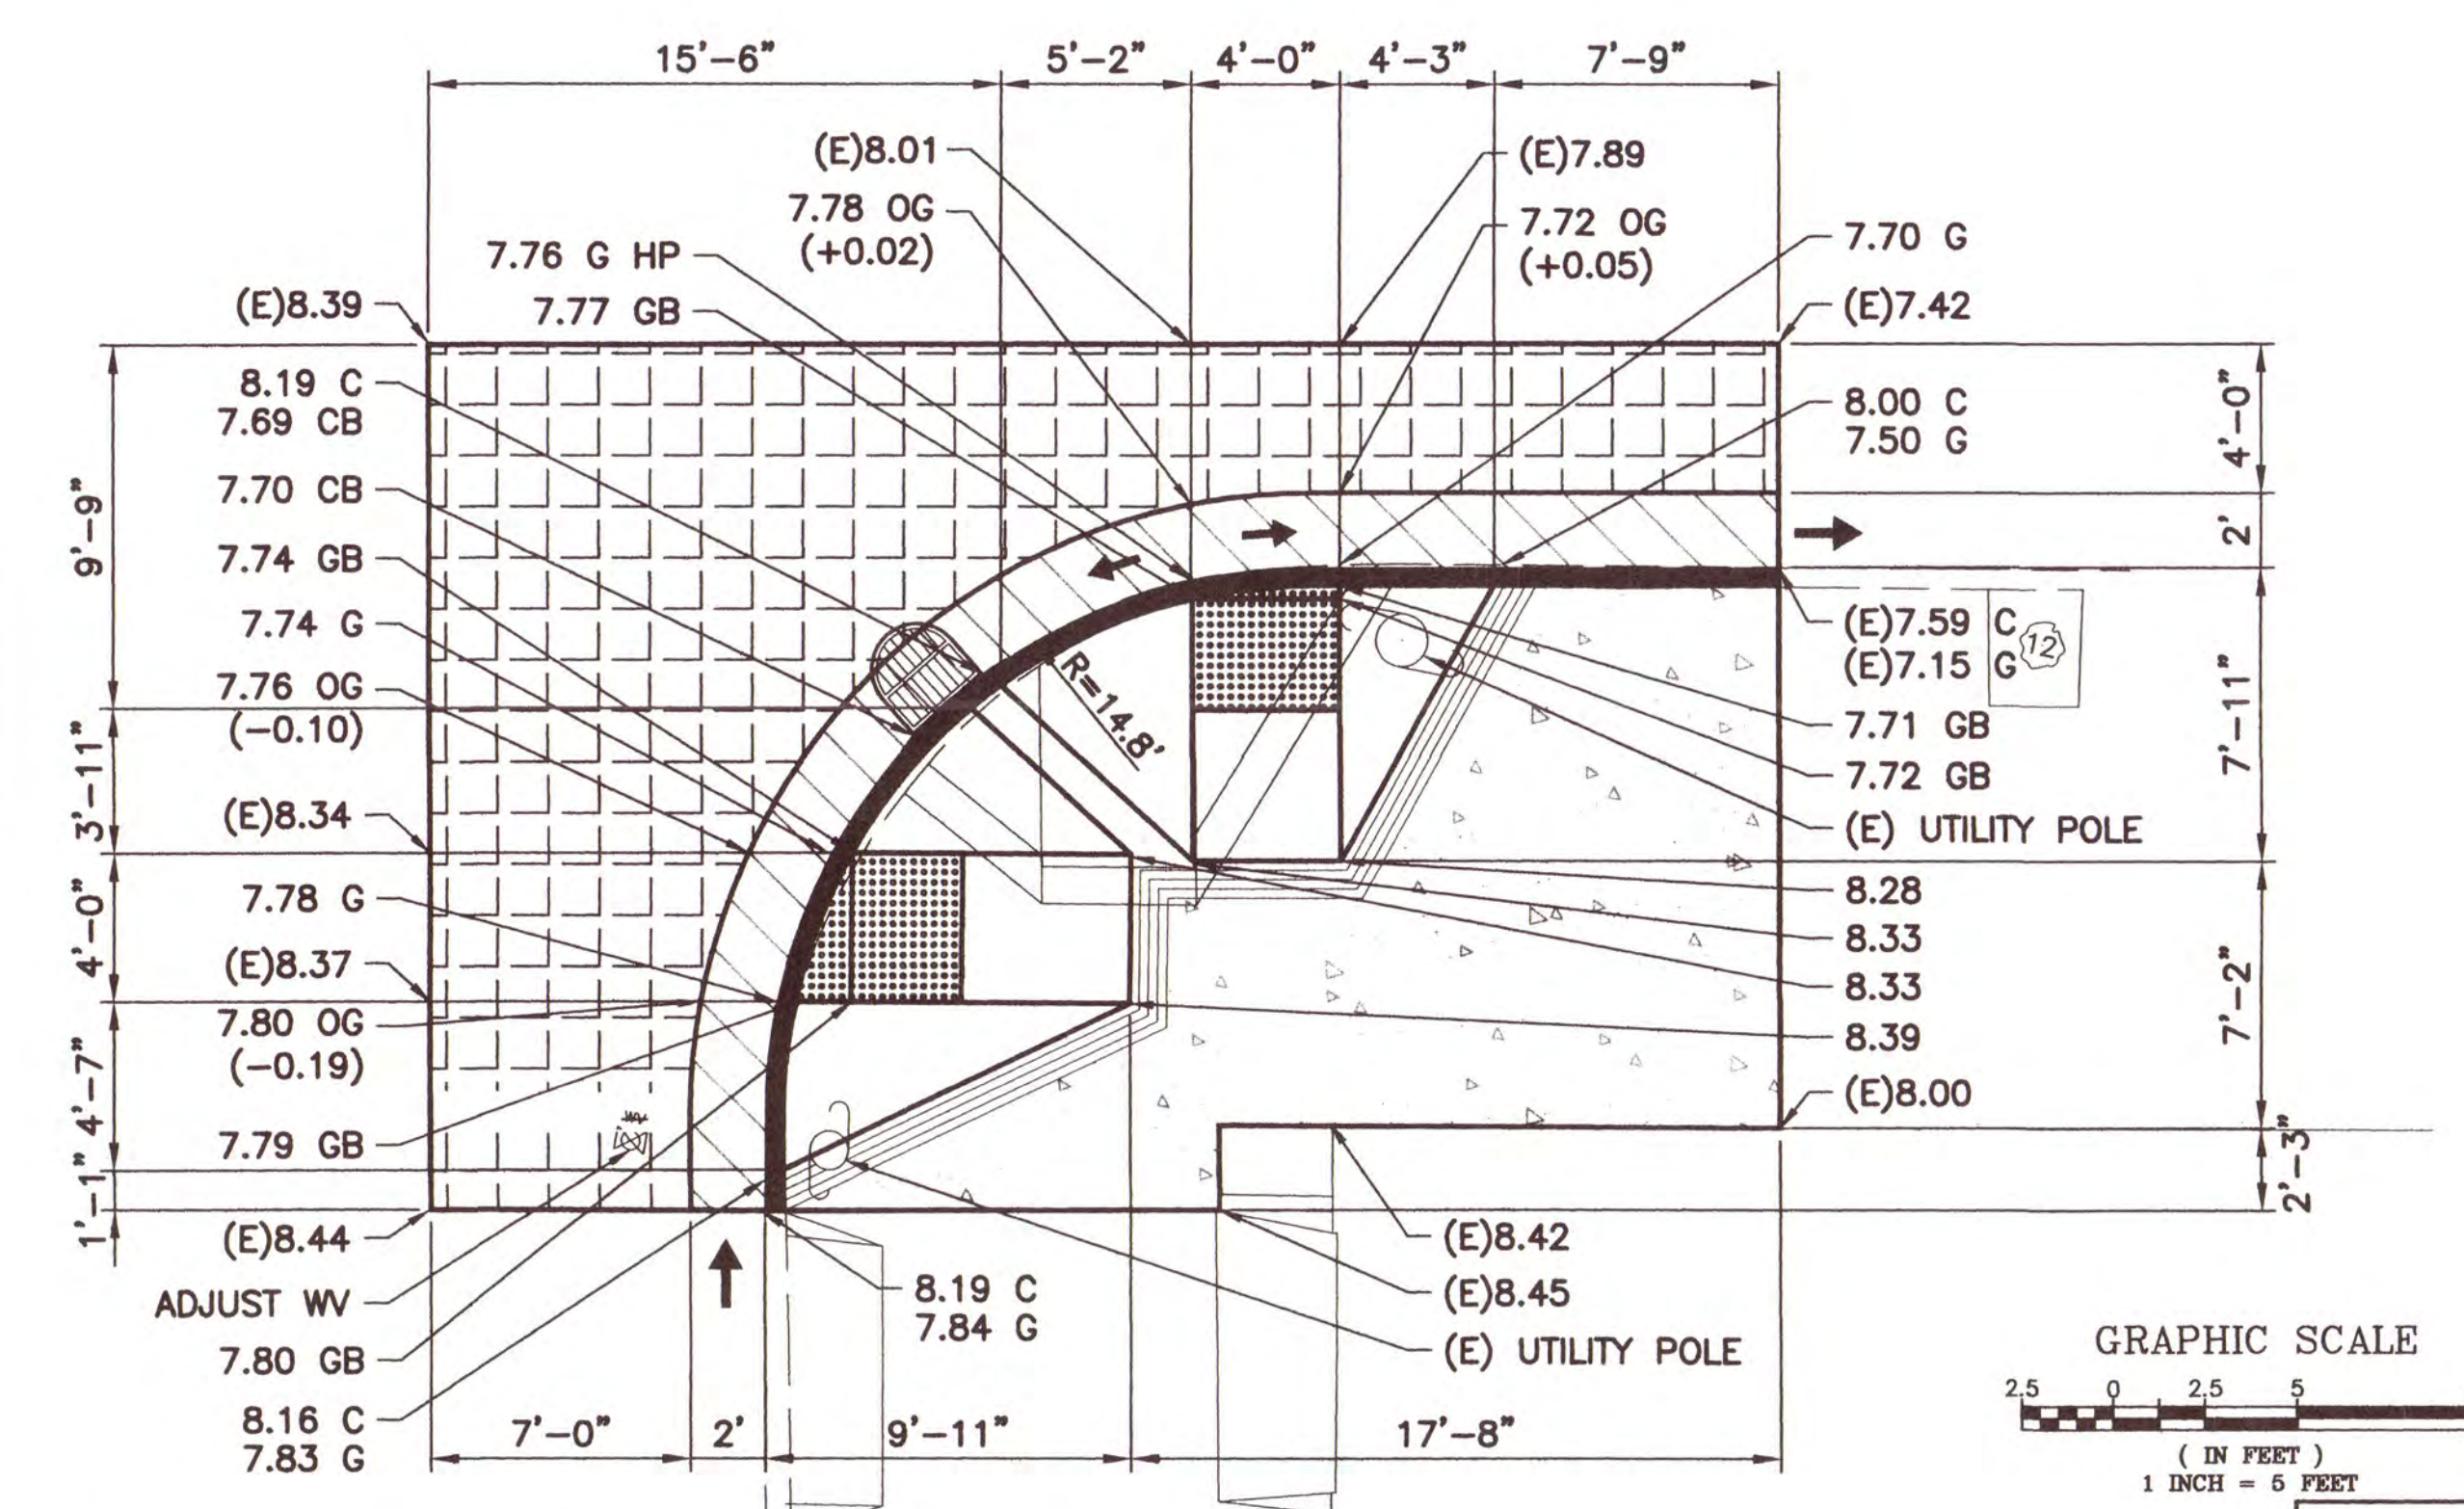

NO.	DATE	DESCRIPTION	BY	APP.
1	03/14/18	TABLE OF REVISIONS	royce	
THIS DRAWING WAS LAST MODIFIED: 03/14/18 12:33, BY: royce				

REFERENCE INFORMATION  
& FILE NO. OF SURVEYS

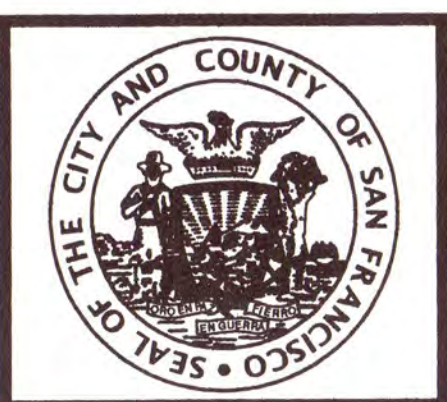

DESIGN & ENGINEERING  
CITY & COUNTY OF SAN FRANCISCO  
SAN FRANCISCO PUBLIC WORKS  
30 VAN NESS AVENUE, 5TH FLOOR  
SAN FRANCISCO, CA 94102 - 6028

Section Mgr:	<i>Eric T. Kibling</i>	Date:	5/16/18
Deputy Division Mgr:	<i>Fabrizio</i>	Date:	5/16/18
Division Mgr:	<i>Paul M. Am</i>	Date:	5/16/18

DESIGNED:	DATE:
TBM	10/19/16
DRAWN:	DATE:
ROO	11/15/16
CHECKED:	DATE:
FCN	12/7/16



SCALE:  
1"=5'  
SHEET OF SHEETS  
46 OF 89

VARIOUS LOCATIONS PAVEMENT  
RENOVATION NO. 37 AND SEWER REPLACEMENT  
CALIFORNIA STREET AND 31ST AVENUE  
CURB RAMP DETAILS

CONTRACT NO.	2792J
DRAWING NO.	CR-22
FILE NO.	109,984
REV. NO.	

Xrefs: X:\TOPO-CALIFORNIA & 31st.dwg  
N:\2015\1568001.17 - Curb Ramps 2792J.dwg  
Various No. 31\DE1\_TB\_22x34\_2792J.dwg  
Model Units: Undefined  
Drawing Path: N:\2015\1568001.17 - Curb Ramps 2792J.dwg  
Plot Time: Wed, 14 Mar 2018 - 12:37pm