

FILE: NAME\\V\\2963J_Various Locations_Sewer_Replacement-JV_with_VL_PR_No37\\2_Design\\Working_Drawings\\E\\E\\Current\\2963J_Ma-03 Alameda.dwg

SAVE\\Monday, March 05, 2018 11:19:45 AM

LOT: EXTENTS
CALE: 1:1
ORDER:
22,34
OLOR: No.
ED 0.70MM
ELLOW 0.20MM
REEN 0.25MM
YAN 0.40MM
LUE 0.50MM
AGENTA 0.20MM
HITE 0.35MM
RAY 0.15MM
0 0.15MM
30 1.00MM
10 0.50MM
0.50MM


FILE:

FOR REDUCED PLANS ORIGINAL SCALE IS IN INCHES

0 20' 40'

SHEET 80 OF 89

SPW JOB ORDER NO. 2963J

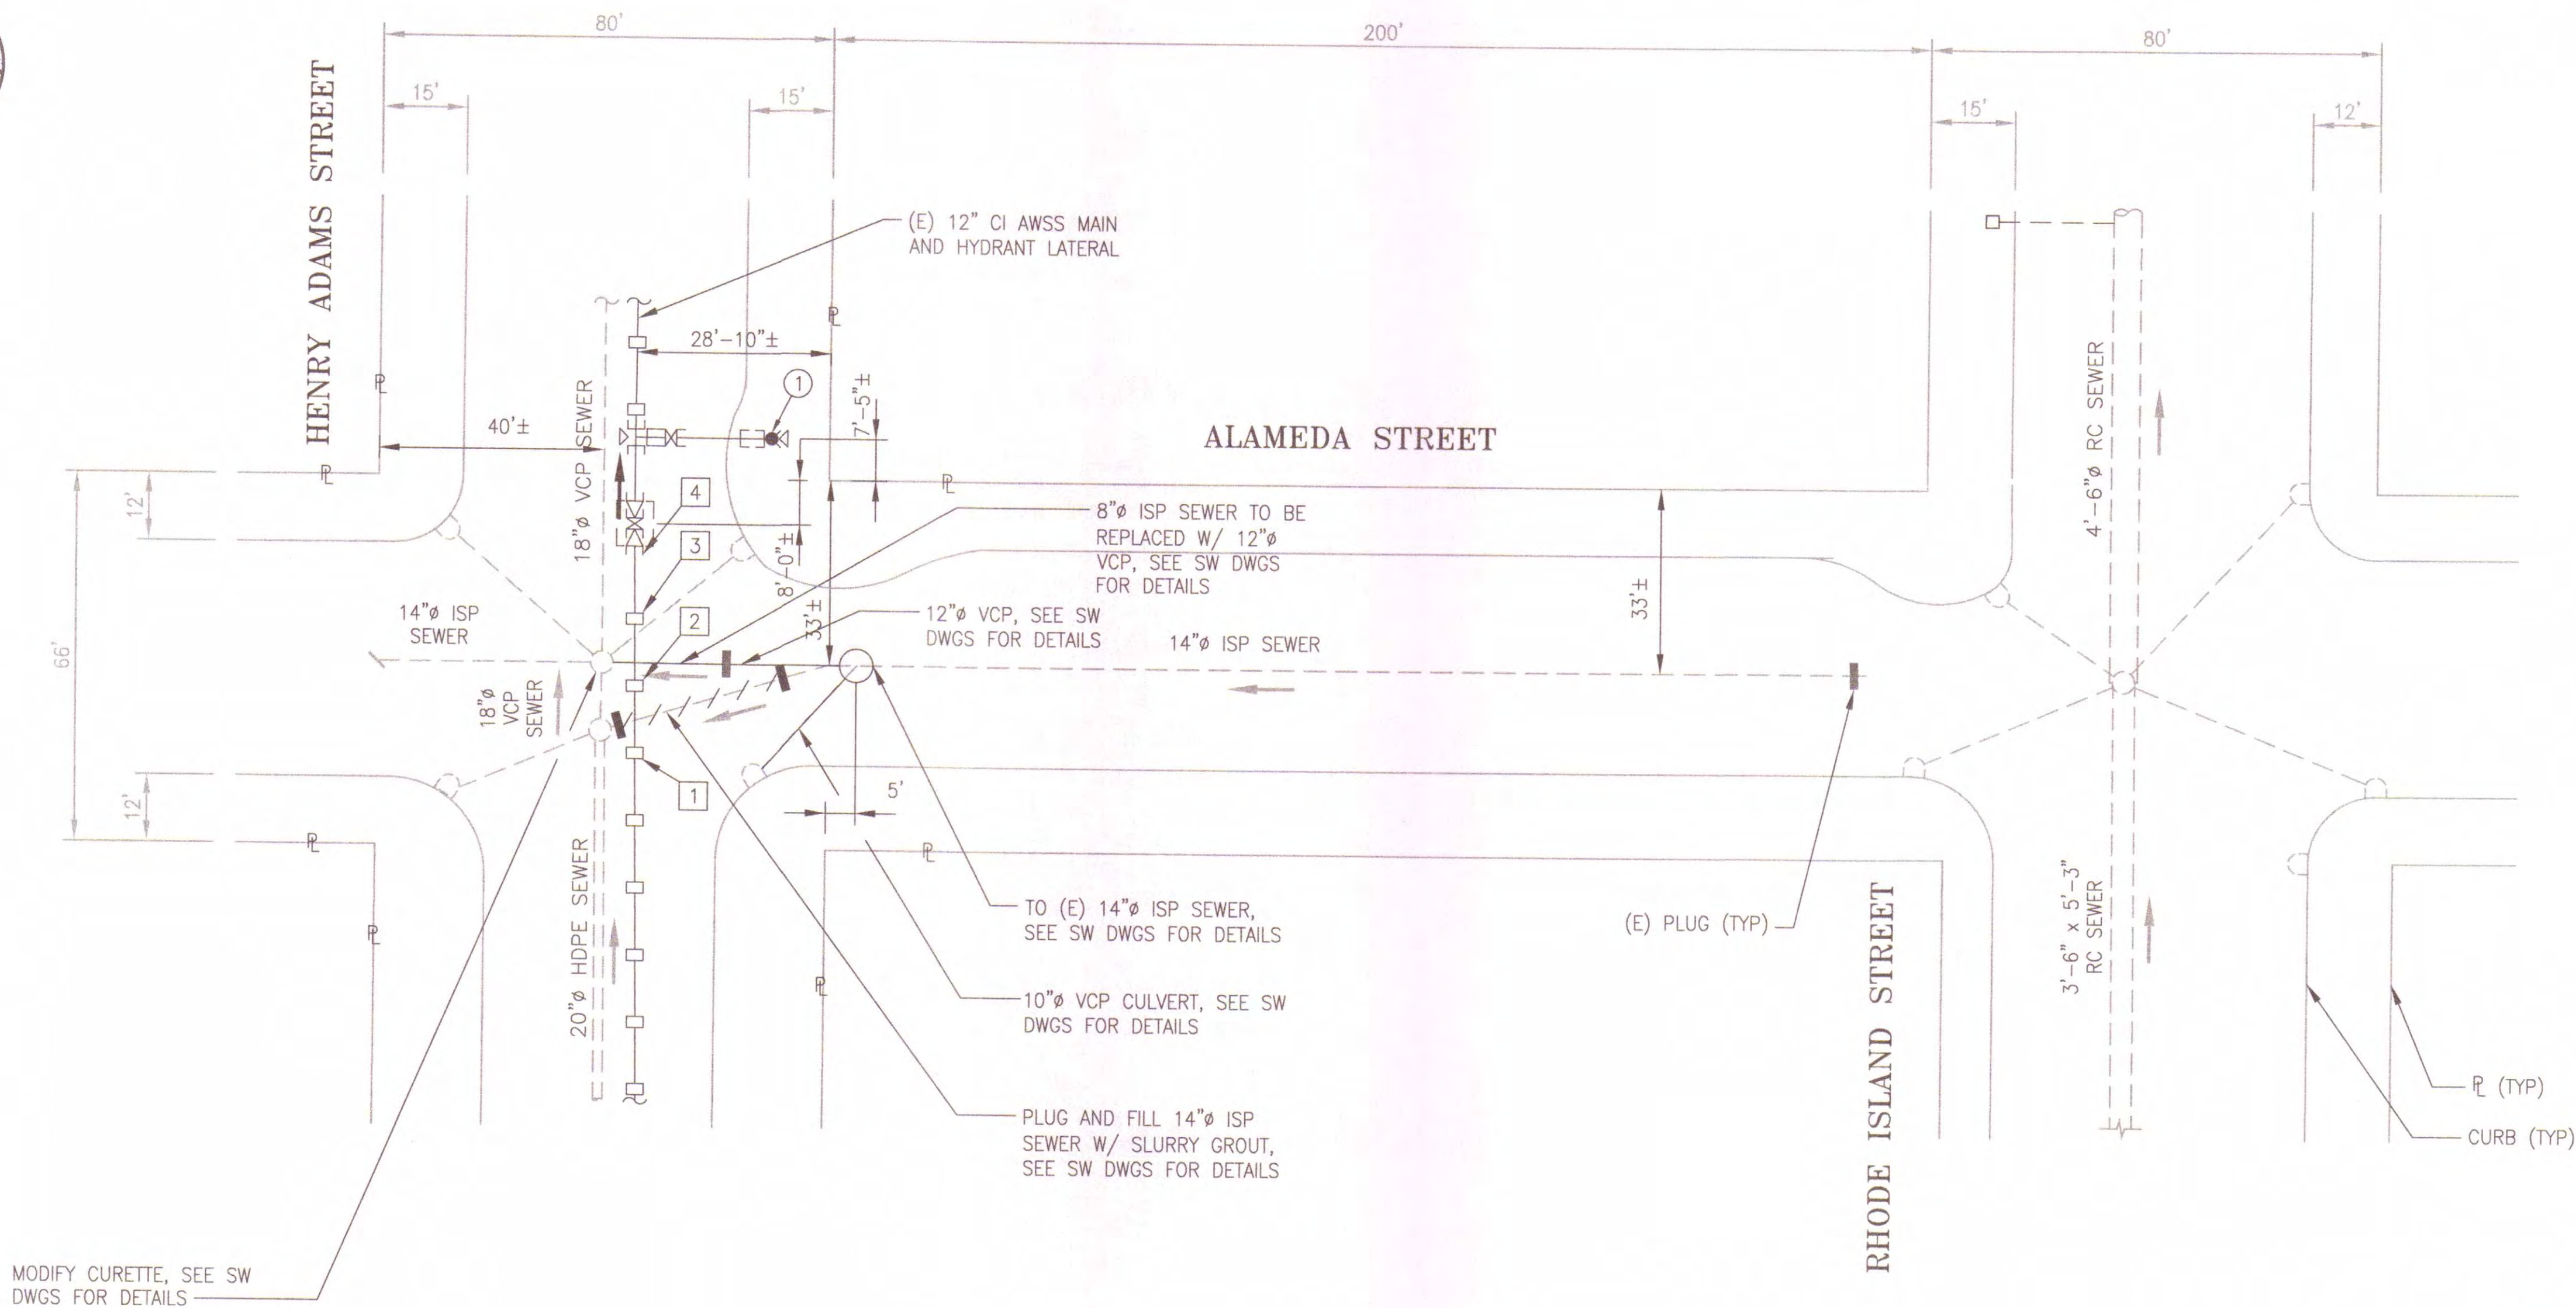

NEW WORK - SETTLEMENT MONITORING - PLAN
SCALE: 1"=20'-0"

LOCATION NO. 1 (HENRY ADAMS AND ALAMEDA STREETS)

ALL AWSS SMP WORK
AT LOCATION NO. 1
DELETED PER RESPONSE
TO RFI 6.

PRECISION
ENGINEERING
1939 NEWCOMB AVENUE
SAN FRANCISCO, CA 94124

AS BUILT
DRAWINGS
Sign *[Signature]*

NOTES:

1. REFER TO DWG MA-01 FOR SURVEY MONITORING AND PIPE SUPPORT NOTES.
2. REFER TO DWG MA-02 FOR GENERAL NOTES, ABBREVIATIONS AND LEGEND.
3. REFER TO SEWER DWGS IN THE CONTRACT PACKAGE FOR ADDITIONAL WORK AT THIS LOCATION.
4. EXISTING AWSS PIPING ELEVATIONS FROM FINISHED GRADE TO CENTERLINE OF PIPE PER RECORD DWGS AS PROVIDED BY THE SFPUC:
 - 12" CI MAIN ON HENRY ADAMS STREET AT ALAMEDA STREET: 6'-10"±

REFERENCES

GATE BOOK PAGES, PLANS,
SURVEY NOTES, ETC. USED

GATE BOOK PAGES
NO.

AWSS DWG NO.
437



CITY AND COUNTY OF SAN FRANCISCO SAN FRANCISCO PUBLIC WORKS DESIGN AND ENGINEERING			
SECTION MANAGER	4/6/18	DRAWN	4/2018
DEPUTY BUREAU MANAGER	4/6/18	DESIGNED	4/2018
BUREAU MANAGER	4/6/18	CHECKED	4/2018
NO.	DATE	DESCRIPTION	BY
REVISIONS			

CONTRACT NO. 2792J CITY AND COUNTY OF SAN FRANCISCO PUBLIC UTILITIES COMMISSION WATER ENTERPRISE CITY DISTRIBUTION DIVISION VARIOUS LOCATIONS PAVEMENT RENOVATION NO. 37 AND SEWER REPLACEMENT			
AUXILIARY WATER SUPPLY SYSTEM WORK SETTLEMENT MONITORING LOCATION NO. 1 - NEW WORK - PLAN			
APPROVED <i>[Signature]</i> ENGINEERING MANAGER	APPROVED <i>[Signature]</i> MANAGER, CITY DISTRIBUTION DIVISION	SCALE 1"=20'-0"	DATE 4/2018
NO.	DATE	DESCRIPTION	BY
REVISIONS			

MA-03 110,018 0