





PRECISION
ENGINEERING
1939 NEWCOMB AVENUE
SAN FRANCISCO, CA 94124

**AS BUILT
DRAWINGS**

Sign *[Signature]*

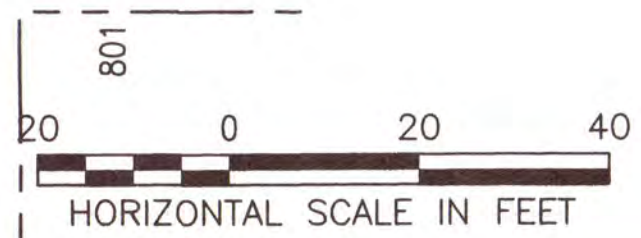

<table border="1"><thead><tr><th>NO.</th><th>DATE</th><th>DESCRIPTION</th><th>BY</th><th>APP.</th></tr></thead><tbody><tr><td colspan="5">TABLE OF REVISIONS</td></tr><tr><td colspan="5">THIS DRAWING WAS LAST MODIFIED: 04/26/18 09:03, BY: L.Louie</td></tr></tbody></table>		NO.	DATE	DESCRIPTION	BY	APP.	TABLE OF REVISIONS					THIS DRAWING WAS LAST MODIFIED: 04/26/18 09:03, BY: L.Louie					REFERENCE INFORMATION & FILE NO. OF SURVEYS				 <p>DESIGN & ENGINEERING CITY & COUNTY OF SAN FRANCISCO SAN FRANCISCO PUBLIC WORKS 30 VAN NESS AVENUE, 5TH FLOOR SAN FRANCISCO, CA 94102 - 6028</p>		<table border="1"><tr><td>Section Mgr:</td><td><i>Eve T. Kibberg</i></td><td>Date:</td><td>5/16/18</td></tr><tr><td>Deputy Division Mgr:</td><td>FERNANDO CISNEROS</td><td>Date:</td><td>5/16/18</td></tr><tr><td>Division Mgr:</td><td>PATRICK RIVERA</td><td>Date:</td><td>5/16/18</td></tr></table>		Section Mgr:	<i>Eve T. Kibberg</i>	Date:	5/16/18	Deputy Division Mgr:	FERNANDO CISNEROS	Date:	5/16/18	Division Mgr:	PATRICK RIVERA	Date:	5/16/18	<table border="1"><tr><td>DESIGNED:</td><td>L.LOUIE</td><td>DATE:</td><td>02/18</td></tr><tr><td>DRAWN:</td><td>J.B.</td><td>DATE:</td><td>02/18</td></tr><tr><td>CHECKED:</td><td>J.BLEA</td><td>DATE:</td><td>02/18</td></tr><tr><td>DATE:</td><td>D.CALLEROS</td><td>DATE:</td><td>03/18</td></tr></table>		DESIGNED:	L.LOUIE	DATE:	02/18	DRAWN:	J.B.	DATE:	02/18	CHECKED:	J.BLEA	DATE:	02/18	DATE:	D.CALLEROS	DATE:	03/18			SCALE: 1" = 20'		SHEET OF SHEETS 11 OF 89		VARIOUS LOCATIONS PAVEMENT RENOVATION NO. 37 AND SEWER REPLACEMENT		CONTRACT NO. 2792J	
NO.	DATE	DESCRIPTION	BY	APP.																																																												
TABLE OF REVISIONS																																																																
THIS DRAWING WAS LAST MODIFIED: 04/26/18 09:03, BY: L.Louie																																																																
Section Mgr:	<i>Eve T. Kibberg</i>	Date:	5/16/18																																																													
Deputy Division Mgr:	FERNANDO CISNEROS	Date:	5/16/18																																																													
Division Mgr:	PATRICK RIVERA	Date:	5/16/18																																																													
DESIGNED:	L.LOUIE	DATE:	02/18																																																													
DRAWN:	J.B.	DATE:	02/18																																																													
CHECKED:	J.BLEA	DATE:	02/18																																																													
DATE:	D.CALLEROS	DATE:	03/18																																																													
PAVEMENT PLAN VERMONT ST - 19TH ST TO 20TH ST 20TH ST - VERMONT ST TO RHODE ISLAND ST										DRAWING NO. R-6																																																						
										FILE NO. 109,950																																																						
										REV. NO.																																																						

Xrefs: V:\2963J_Various_Locations_Sewer_Replacement-IV_VL_PR_No.37\Official_Project_TBS\01_TB_22x34.dwg
V:\2963J_Various_Locations_Sewer_Replacement-IV_VL_PR_No.37\2_Design_Working_Drawings\EHY\2963J_SW1
V:\2963J_Various_Locations_Sewer_Replacement-IV_VL_PR_No.37\2_Design_Working_Drawings\EHY\2963J_SW4
V:\2963J_Various_Locations_Sewer_Replacement-IV_VL_PR_No.37\2_Design_Working_Drawings\EHY\2963J_SW5
Drawing Path: V:\2963J_Various_Locations_Sewer_Replacement-IV_VL_PR_No.37\Official_Project_TBS\01_TB_22x34.dwg
Plot Time: Thu, 26 Apr 2018 - 9:06am
Model Units: Feet
Login: Llouie