
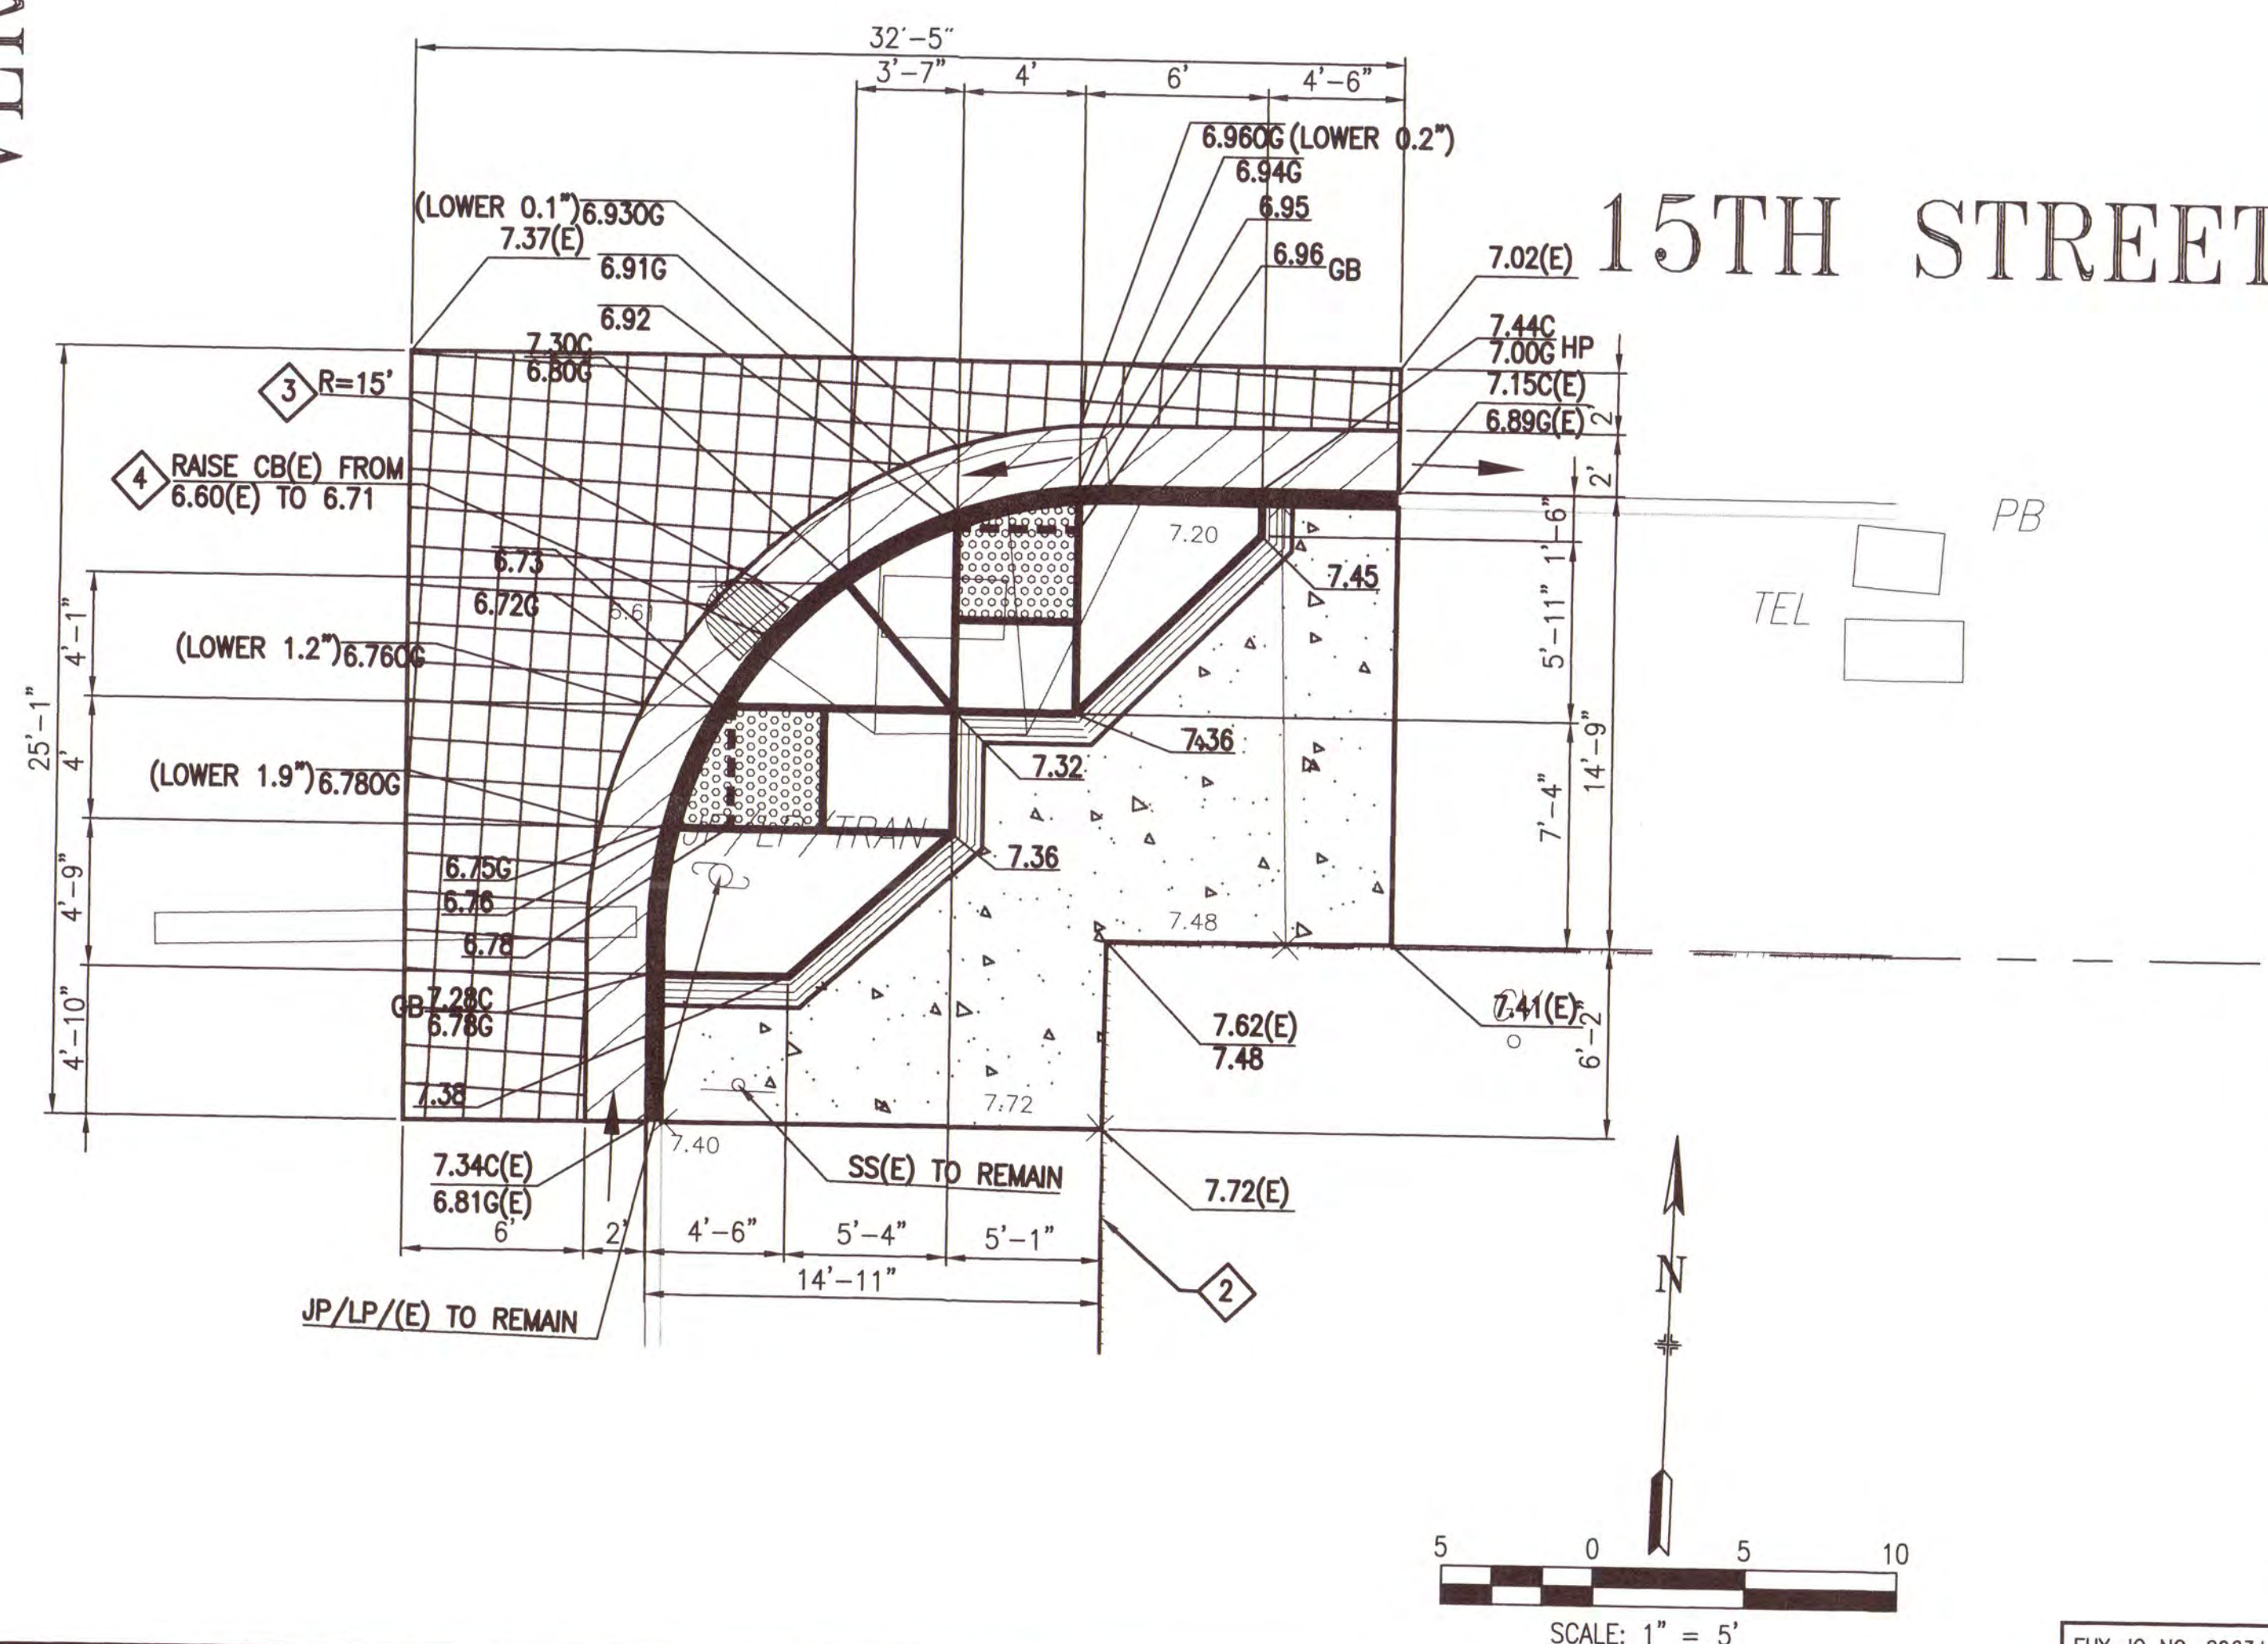
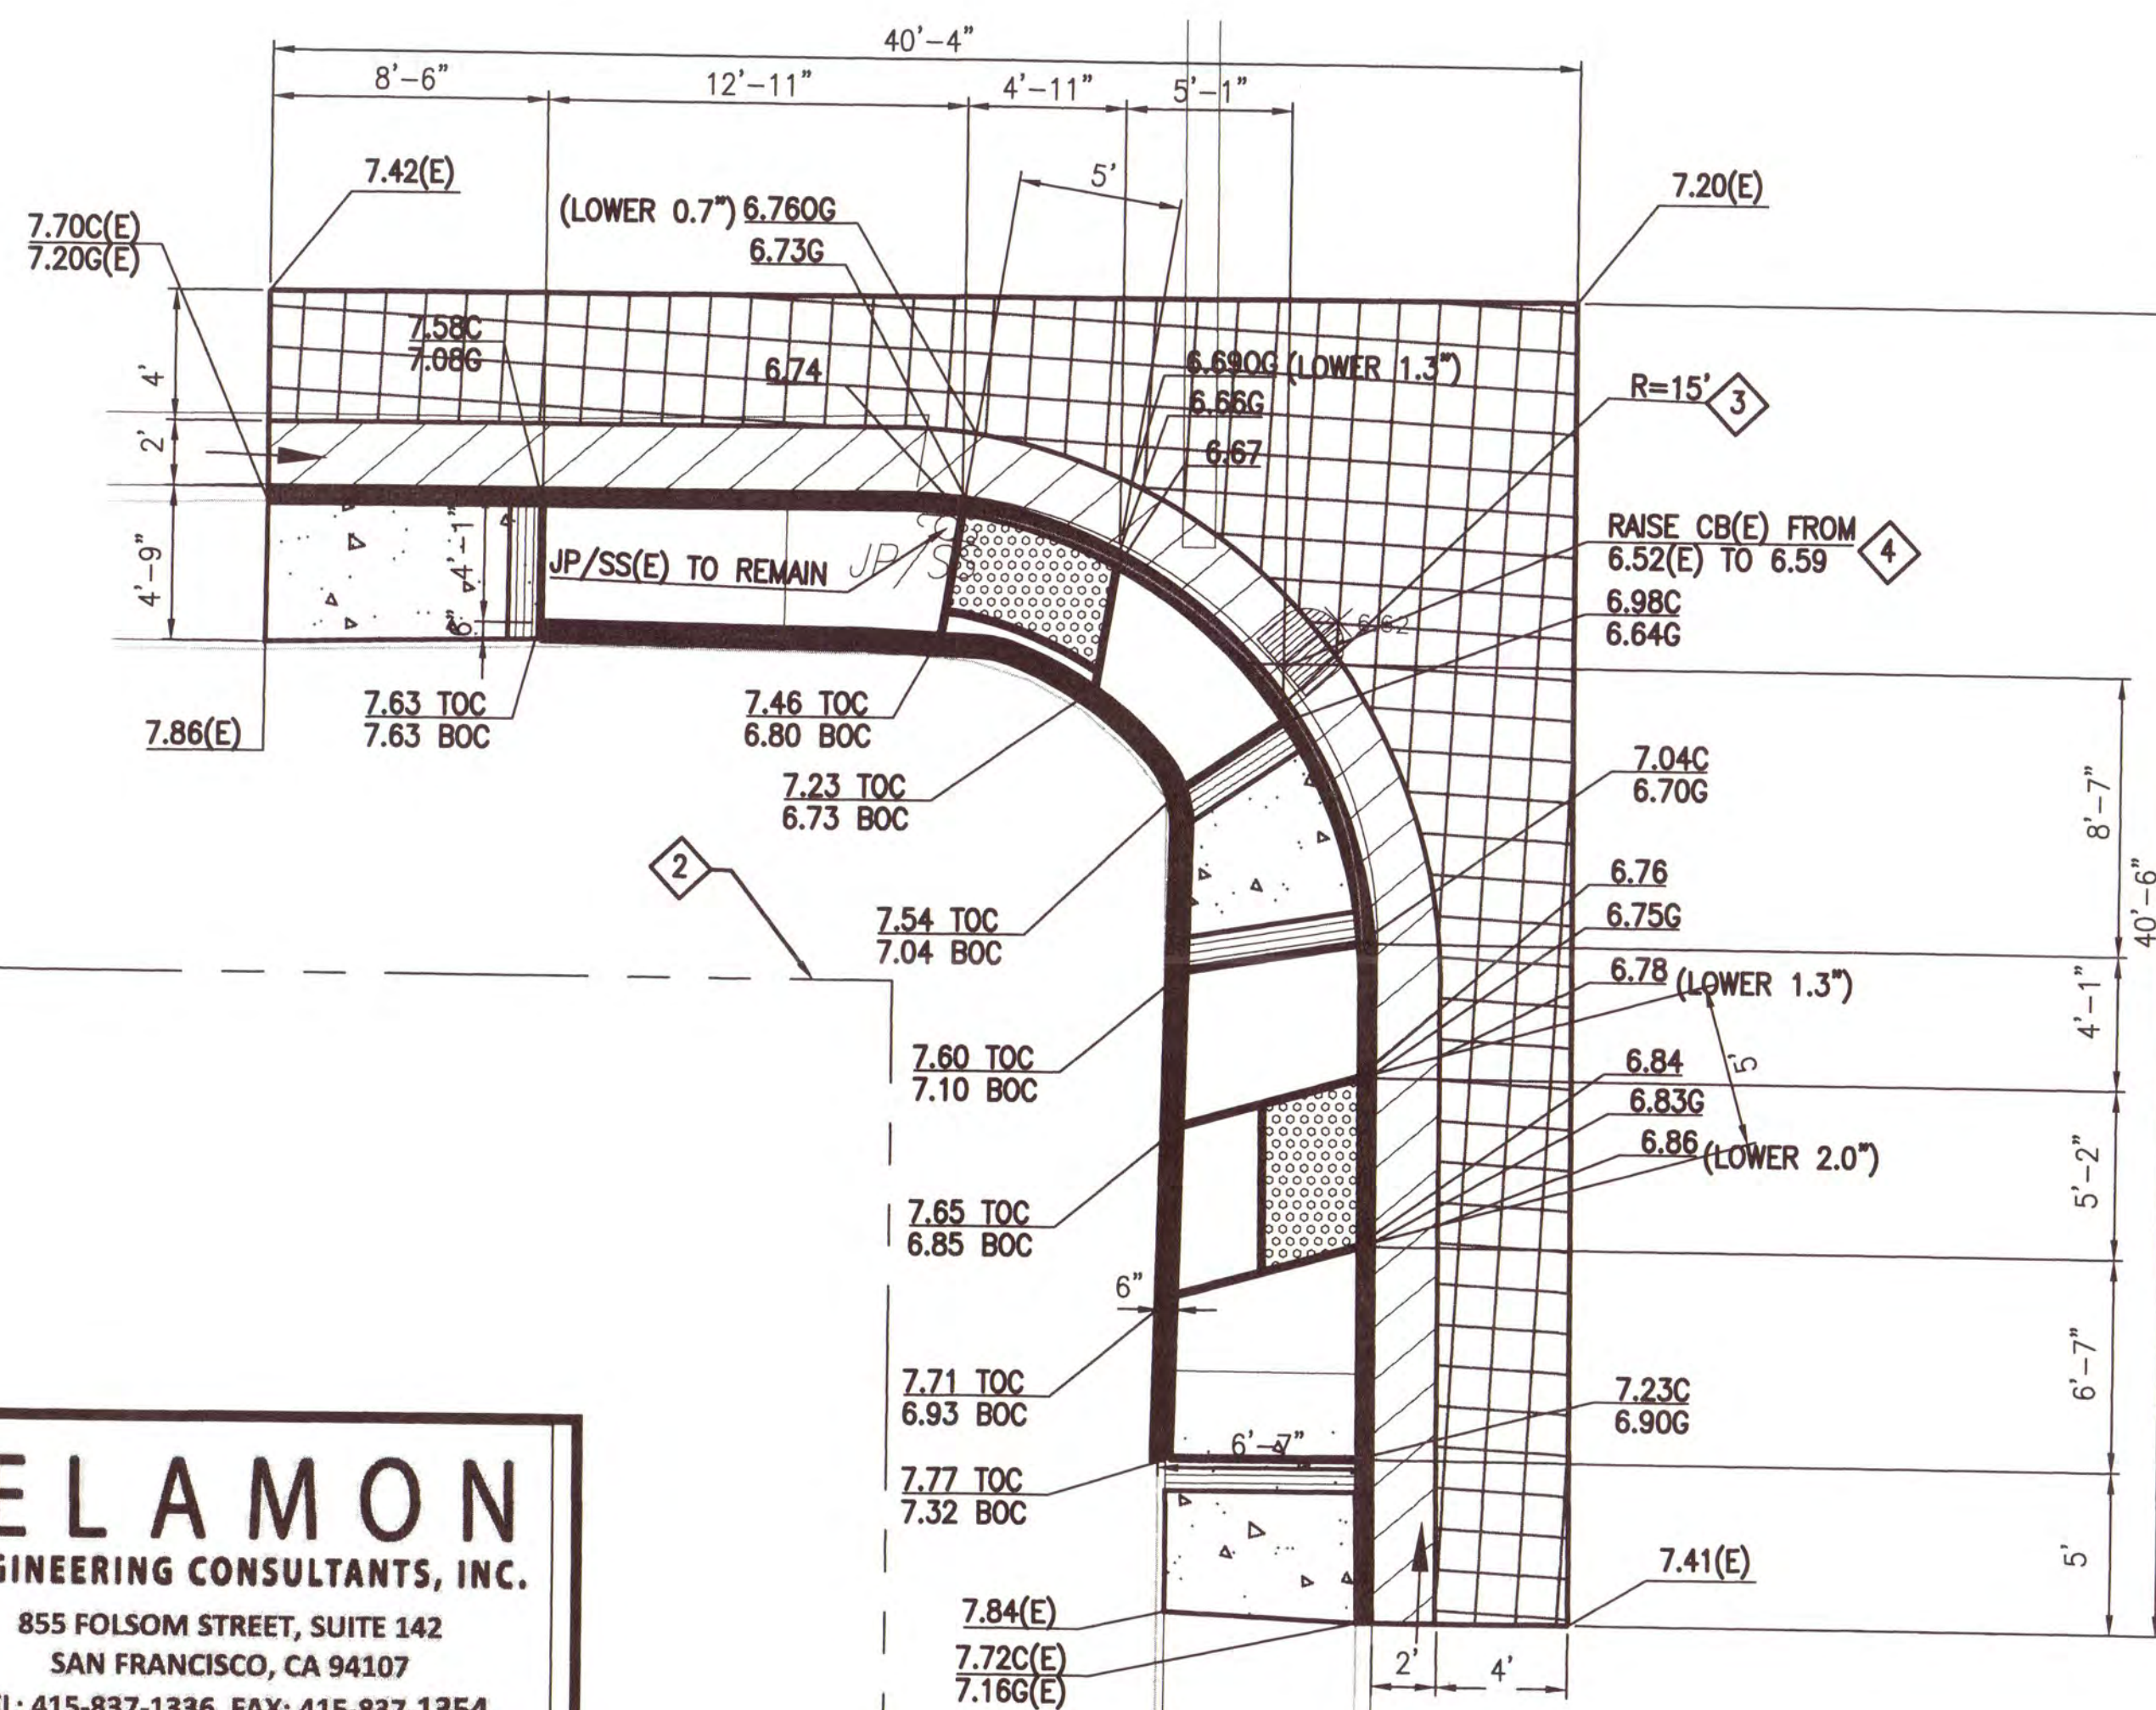


1. TOPOGRAPHIC SURVEY PERFORMED BY TELAMON ENGINEERING CONSULTANTS, INC. IN MAY 2015 USING AN ASSUMED HORIZONTAL AND VERTICAL DATUM, SEE REFERENCE POINT ON TOP OF LPFH.
2. PROPERTY LINE IS APPROXIMATE AND BASED ON THE LATEST GRADE MAP INFORMATION OBTAINED FROM THE CITY & COUNTY OF SAN FRANCISCO DEPARTMENT OF PUBLIC WORKS (SFPDW) WEBSITE: "[HTTP://BDM.SFPDW.ORG/SUBDIVISION/KEYMAP/](http://BDM.SFPDW.ORG/SUBDIVISION/KEYMAP/)".
3. FACE OF CURB BSM AS NOTED.
4. ADJUST CATCH BASIN AND GRATE TO NEW CURB ALIGNMENT.
5. CONTACT BUREAU OF STREET USE AND MAPPING TO COORDINATE MODIFICATION OF MONUMENT PRIOR TO CONSTRUCTION.

 **PRECISION**
ENGINEERING
1939 NEWCOMB AVENUE
SAN FRANCISCO, CA 94124

AS BUILT
DRAWINGS
Sign 



DESIGN &
ENGINEERING
PUBLIC WORKS
CITY & COUNTY OF SAN FRANCISCO
30 VAN NESS AVENUE, 5TH FLOOR
SAN FRANCISCO, CA 94102 - 6028

	Date:
Section Mgr: <i>Eric T. Kibburg</i>	5/16/18
Deputy Division Mgr: FERNANDO CISNEROS <i>Fab Cisneros</i>	5/16/18
Division Mgr: PATRICK RIVERA <i>Patrick Rivera</i>	5/16/18

DESIGNED:	DATE:
DZ	04/18
DRAWN:	DATE:
KN	04/18
CHECKED:	DATE:
MC	04/18



SCALE:
 $1'' = 5''$
SHEET OF SHEETS
39 OF 89

VARIOUS LOCATIONS
RENOVATION NO. 37 AND SEWER REPLACEMENT

15TH ST AND VERMONT ST - SOUTH
CURB RAMP DETAILS

EHY JO NO. 2963J
CONTRACT NO. 2792J
DRAWING NO. CR-16A
FILE NO. 109,978
REV. NO.

Drawing Path: P:\16014 CRD 2728J VL Trck Remv\3_Dwg\CRG-16_1514\VERMONT ST.dwg Login: Doug
Plot Time: Wed, 25 Apr 2018 ~ 2:07pm Measurement Units are English