

PLAN
SCALE: 1"=30'

SHEET NOTES:


1. SIDE SEWERS AND (N) CURB WILL BE CONSTRUCTED BY OTHERS PRIOR TO CONSTRUCTION (NIC). EXTEND AND RECONNECT SIDE SEWER TO (N) MAIN.
2. SEE MA-04 FOR AWSS SETTLEMENT MONITORING.
3. PART OF THE SE STREET. SEE R-68-10-SS WITHIN A CONCRETE STREET. RESTORE SEWER TRENCH PER DETAIL 2.

PRECISION
ENGINEERING
1939 NEWCOMB AVENUE
SAN FRANCISCO, CA 94124

AS BUILT DRAWINGS
Sign *[Signature]*



DETAIL NOTES:

1. SEE SFPW STD PLAN 87,185 FOR ADDITIONAL DETAILS.
2. REMOVE BRICKS AS NECESSARY TO ACCOMMODATE (N) SEWER CONNECTION AND FILL ANNULAR SPACE BETWEEN (E) BRICK SEWER AND VCP CONNECTION WITH NON-SHRINK GROUT.

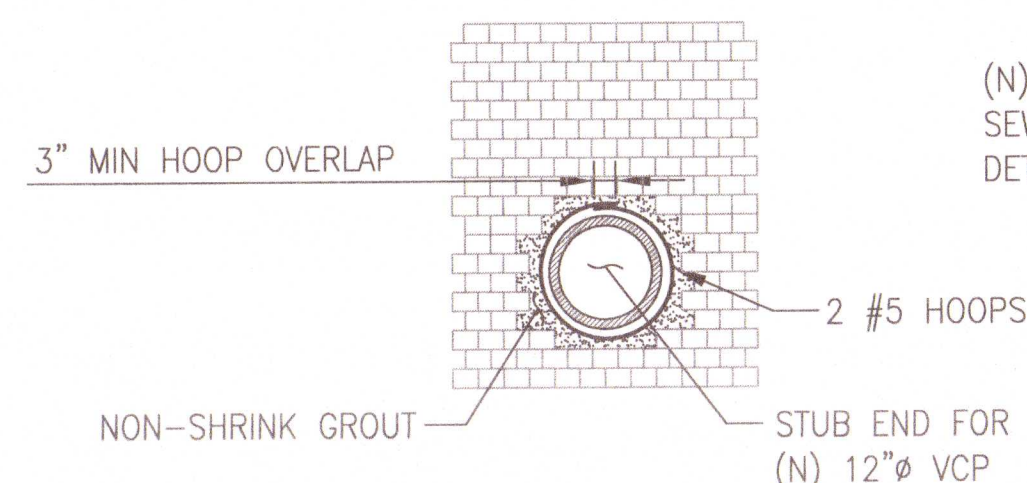


SECTION A-A

MH CONNECTION DETAIL 1

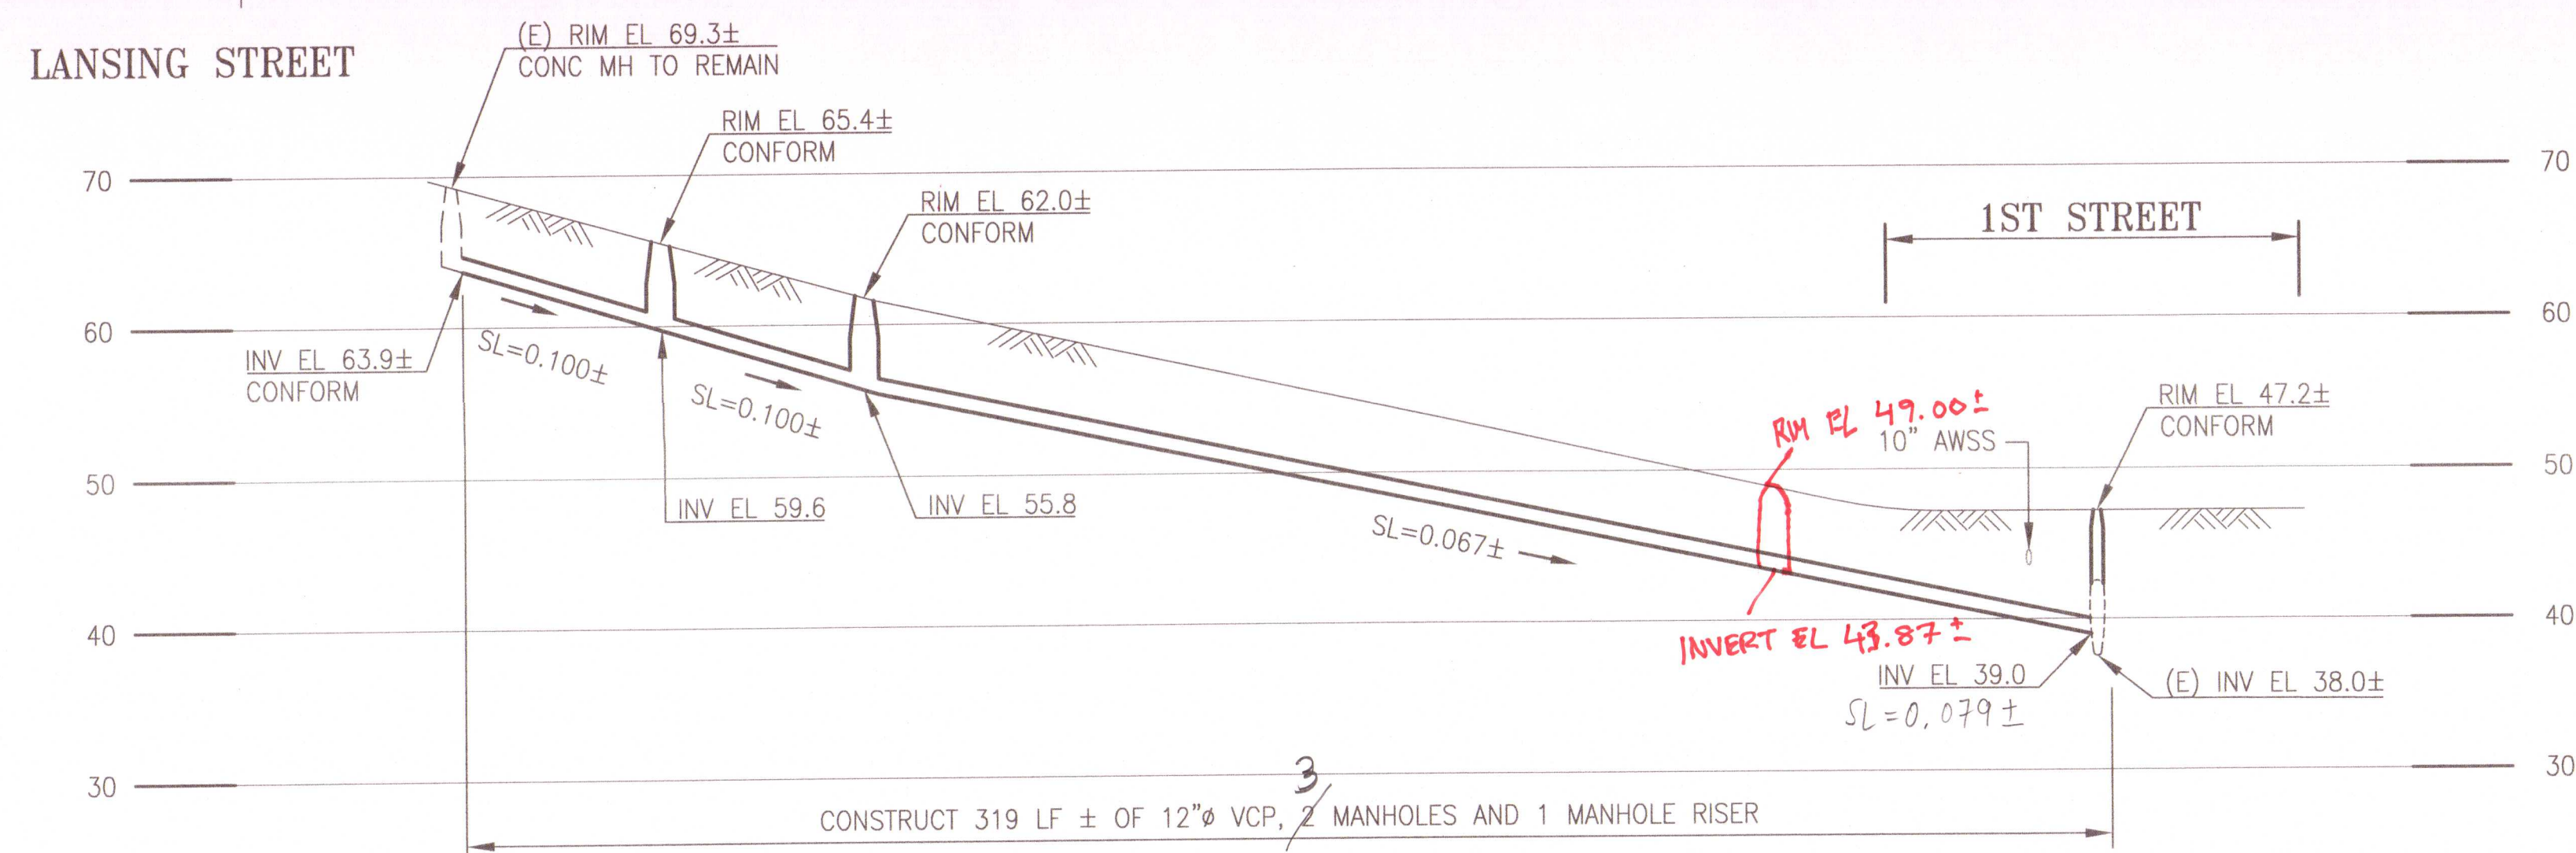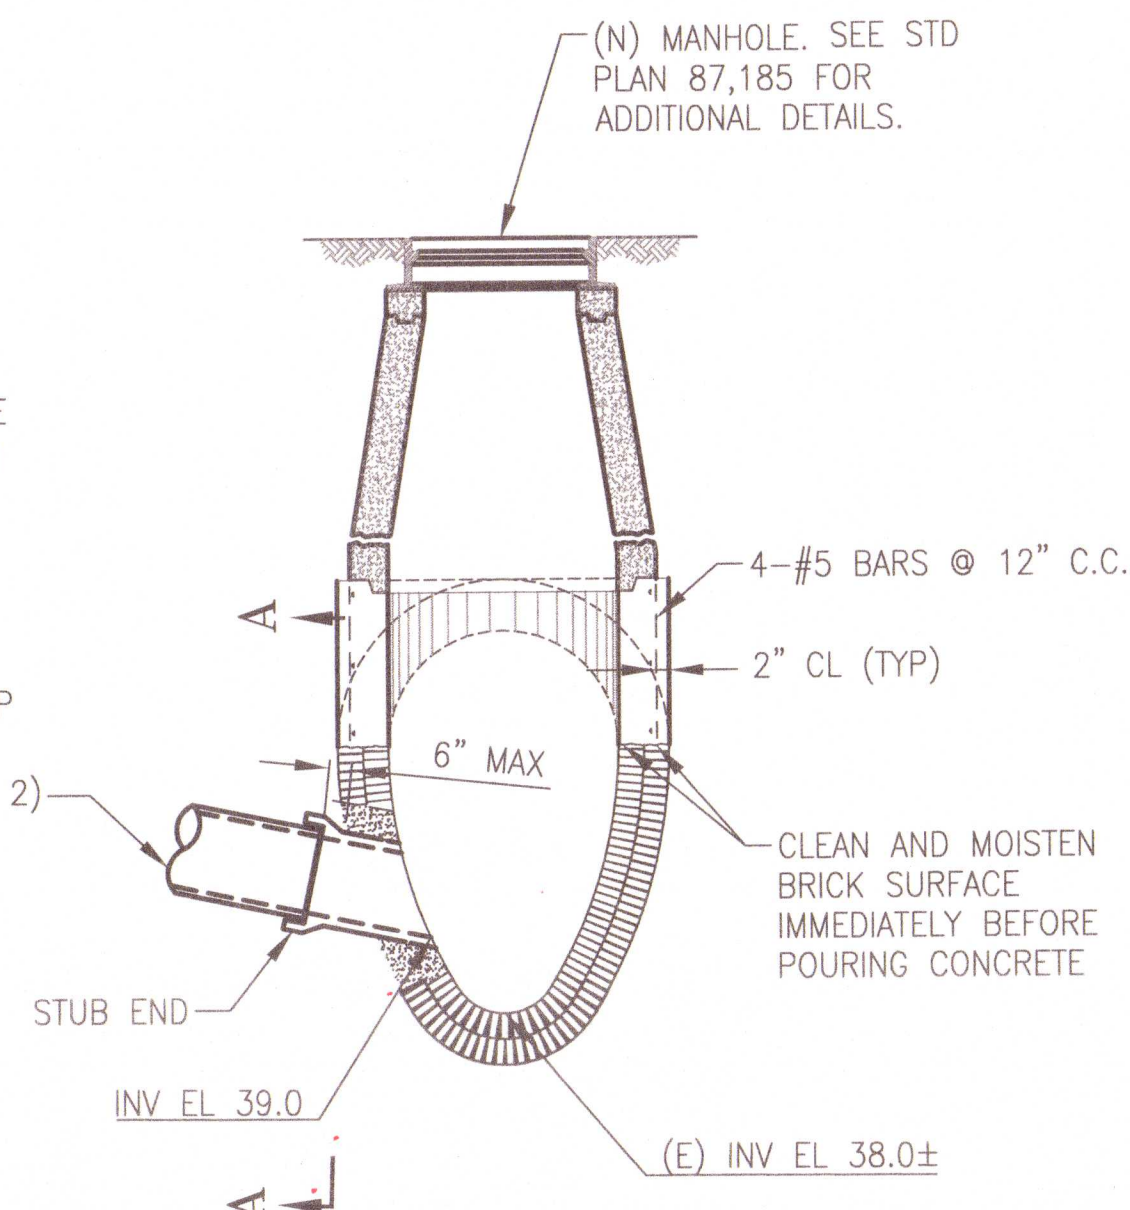


PROFILE
SCALE: HORIZ 1"=30'
VERT 1"=10'

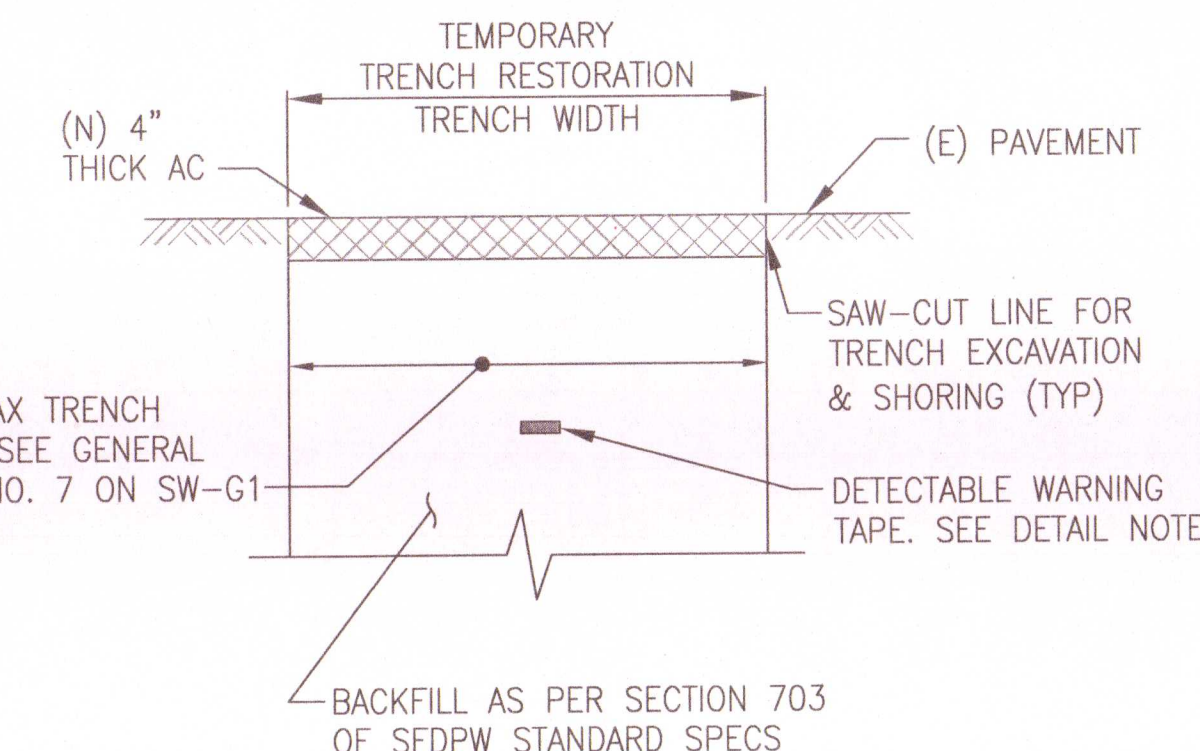

DETAIL NOTE:

DETECTABLE WARNING TAPE SHALL BE 6" WIDE, 5 MIL THICKNESS GREEN METALLIC WARNING TAPE WITH WORDS "CAUTION: BURIED SEWER," AND CENTERED OVER AND PLACED 12" ABOVE THE TOP OF PIPE.

TEMPORARY TRENCH RESTORATION DETAIL FOR CONCRETE STREET 2

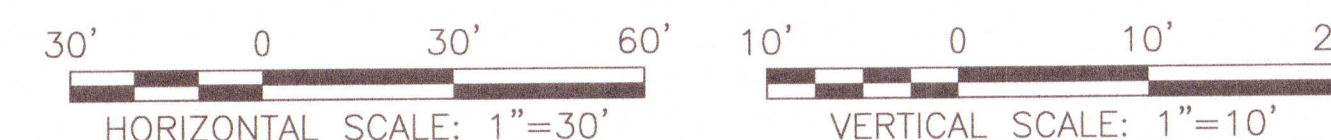

SEWER SIZED BY
Y.W. YW
APPROVED BY
B.S. BS


REFERENCE INFORMATION
& FILE NO. OF SURVEYS
BK-054A_PG-026
WPA275-279
WPA283



DESIGN & ENGINEERING
CITY & COUNTY OF SAN FRANCISCO
SAN FRANCISCO PUBLIC WORKS
30 VAN NESS AVENUE, 5TH FLOOR
SAN FRANCISCO, CA 94102 - 6028

Section Mgr: *[Signature]* LESLEY WONG 4/25/18
Deputy Bureau Mgr: *[Signature]* IQBAL DHAPA 4/27/18
Bureau Mgr: *[Signature]* PATRICK RIVERA 4/27/18

DESIGNED: DATE: J.KUNG 4/2018
DRAWN: DATE: S.HUEY 4/2018
CHECKED: DATE: J.HELMUTH 4/2018

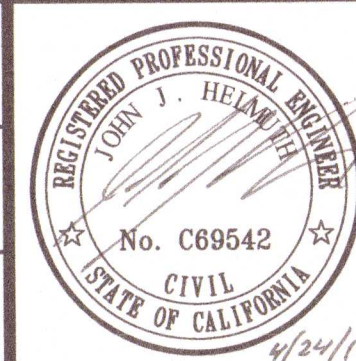

SCALE:
AS NOTED
SHEET OF SHEETS
56 OF 89

VARIOUS LOCATIONS PAVEMENT RENOVATION NO. 37 AND SEWER REPLACEMENT

GUY PLACE SEWER REPLACEMENT LANSING STREET TO 1ST STREET PLAN, PROFILE AND DETAILS

CONTRACT NO.
2792J
DRAWING NO.
SW-6
FILE NO.
109,994
REV. NO.
0