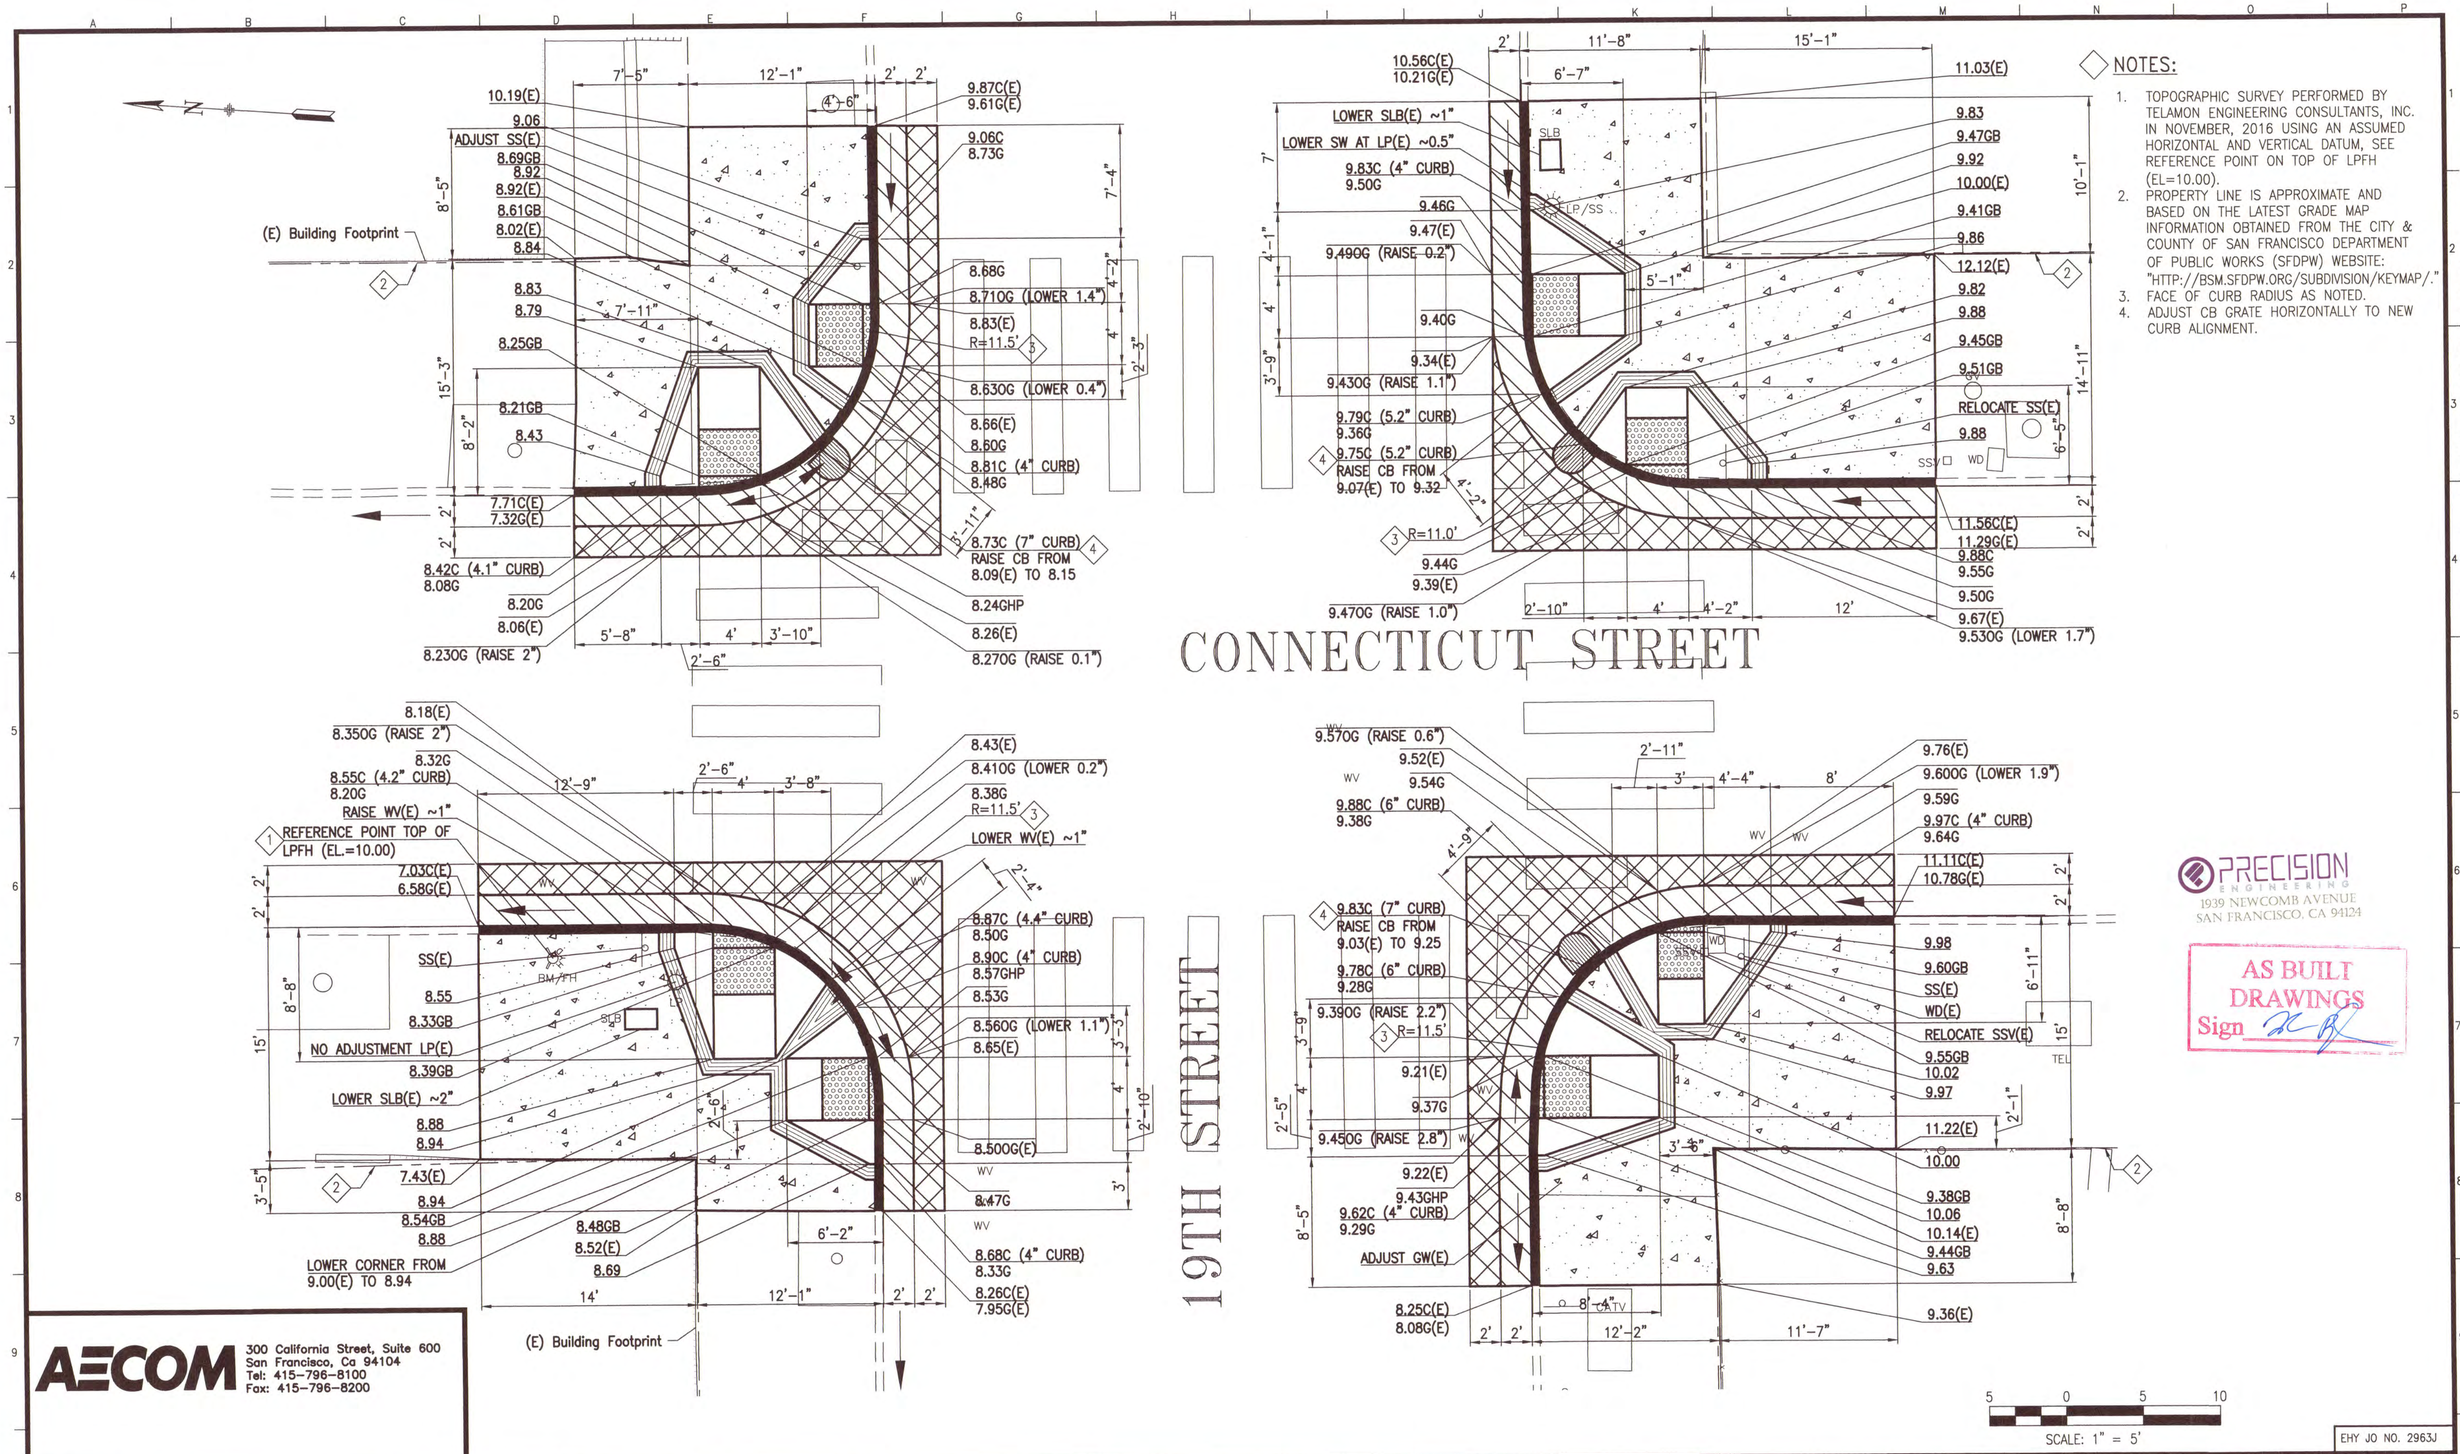


## NOTES:

1. TOPOGRAPHIC SURVEY PERFORMED BY TELAMON ENGINEERING CONSULTANTS, INC. IN NOVEMBER, 2016 USING AN ASSUMED HORIZONTAL AND VERTICAL DATUM, SEE REFERENCE POINT ON TOP OF LPFH (EL=10.00).
2. PROPERTY LINE IS APPROXIMATE AND BASED ON THE LATEST GRADE MAP INFORMATION OBTAINED FROM THE CITY & COUNTY OF SAN FRANCISCO DEPARTMENT OF PUBLIC WORKS (SFDPW) WEBSITE: "HTTP://BSM.SFDPW.ORG/SUBDIVISION/KEYMAP/."
3. FACE OF CURB RADIUS AS NOTED.
4. ADJUST CB GRATE HORIZONTALLY TO NEW CURB ALIGNMENT.

PRECISION ENGINEERING
1939 NEWCOMB AVENUE
SAN FRANCISCO, CA 94124

AS BUILT DRAWINGS
Sign


AECOM
300 California Street, Suite 600
San Francisco, Ca 94104
Tel: 415-796-8100
Fax: 415-796-8200


| NO. | DATE | DESCRIPTION | BY | APP. |
|---|---|---|---|---|

TABLE OF REVISIONS
THIS DRAWING WAS LAST MODIFIED: 11/29/17 17:47, BY: joseph.burg

REFERENCE INFORMATION & FILE NO. OF SURVEYS

SEAL OF THE CITY AND COUNTY OF SAN FRANCISCO

SAN FRANCISCO PUBLIC WORKS

DESIGN & ENGINEERING
CITY & COUNTY OF SAN FRANCISCO
SAN FRANCISCO PUBLIC WORKS
30 VAN NESS AVENUE, 5TH FLOOR
SAN FRANCISCO, CA 94102 - 6028

| | | Date: |
|---|---|---|
| Section Mgr: | Eric T. Kirkbey | 5/16/18 |
| Deputy Division Mgr: | | 5/16/18 |
| Division Mgr: | PATRICK RIVERA | 5/16/18 |

| | | DATE: |
|---|---|---|
| DESIGNED: | A. EHSAE | 04/18 |
| DRAWN: | B. CARPENTER | 04/18 |
| CHECKED: | T. SWEET | 04/18 |

REGISTERED PROFESSIONAL ENGINEER THOMAS SWEET No. C 58265 EXP. 06/30/18 CIVIL STATE OF CALIFORNIA

SCALE: 1" = 5'

SHEET OF SHEETS 33 OF 89

# VARIOUS LOCATIONS PAVEMENT RENOVATION NO. 37 AND SEWER REPLACEMENT

# CONNECTICUT STREET AND 19TH STREET CURB RAMP DETAILS

EHY JO NO. 2963J

CONTRACT NO. 2792J

DRAWING NO. CR-10

FILE NO. 109,972

REV. NO.

Xrefs: T:\SFDPW Various Locations 37 (2792J)\Plan\XC-2792J-BOE Title Block.dwg
T:\SFDPW Various Locations 37 (2792J)\Plan\XC-TOPO CONNECTICUT AND 19TH.dwg
T:\SFDPW Various Locations 37 (2792J)\Plan\XC-DESIGN CONNECTICUT AND 19TH.dwg

Dimension Scale: 5
Model Units: Undefined

Drawing Path: T:\SFDPW Various Locations 37 (2792J)\Sheet\CR-10.dwg, Login: joseph.burg
Plot Time: Mon, 23 Apr 2018 - 7:10pm
Measurement Units are English