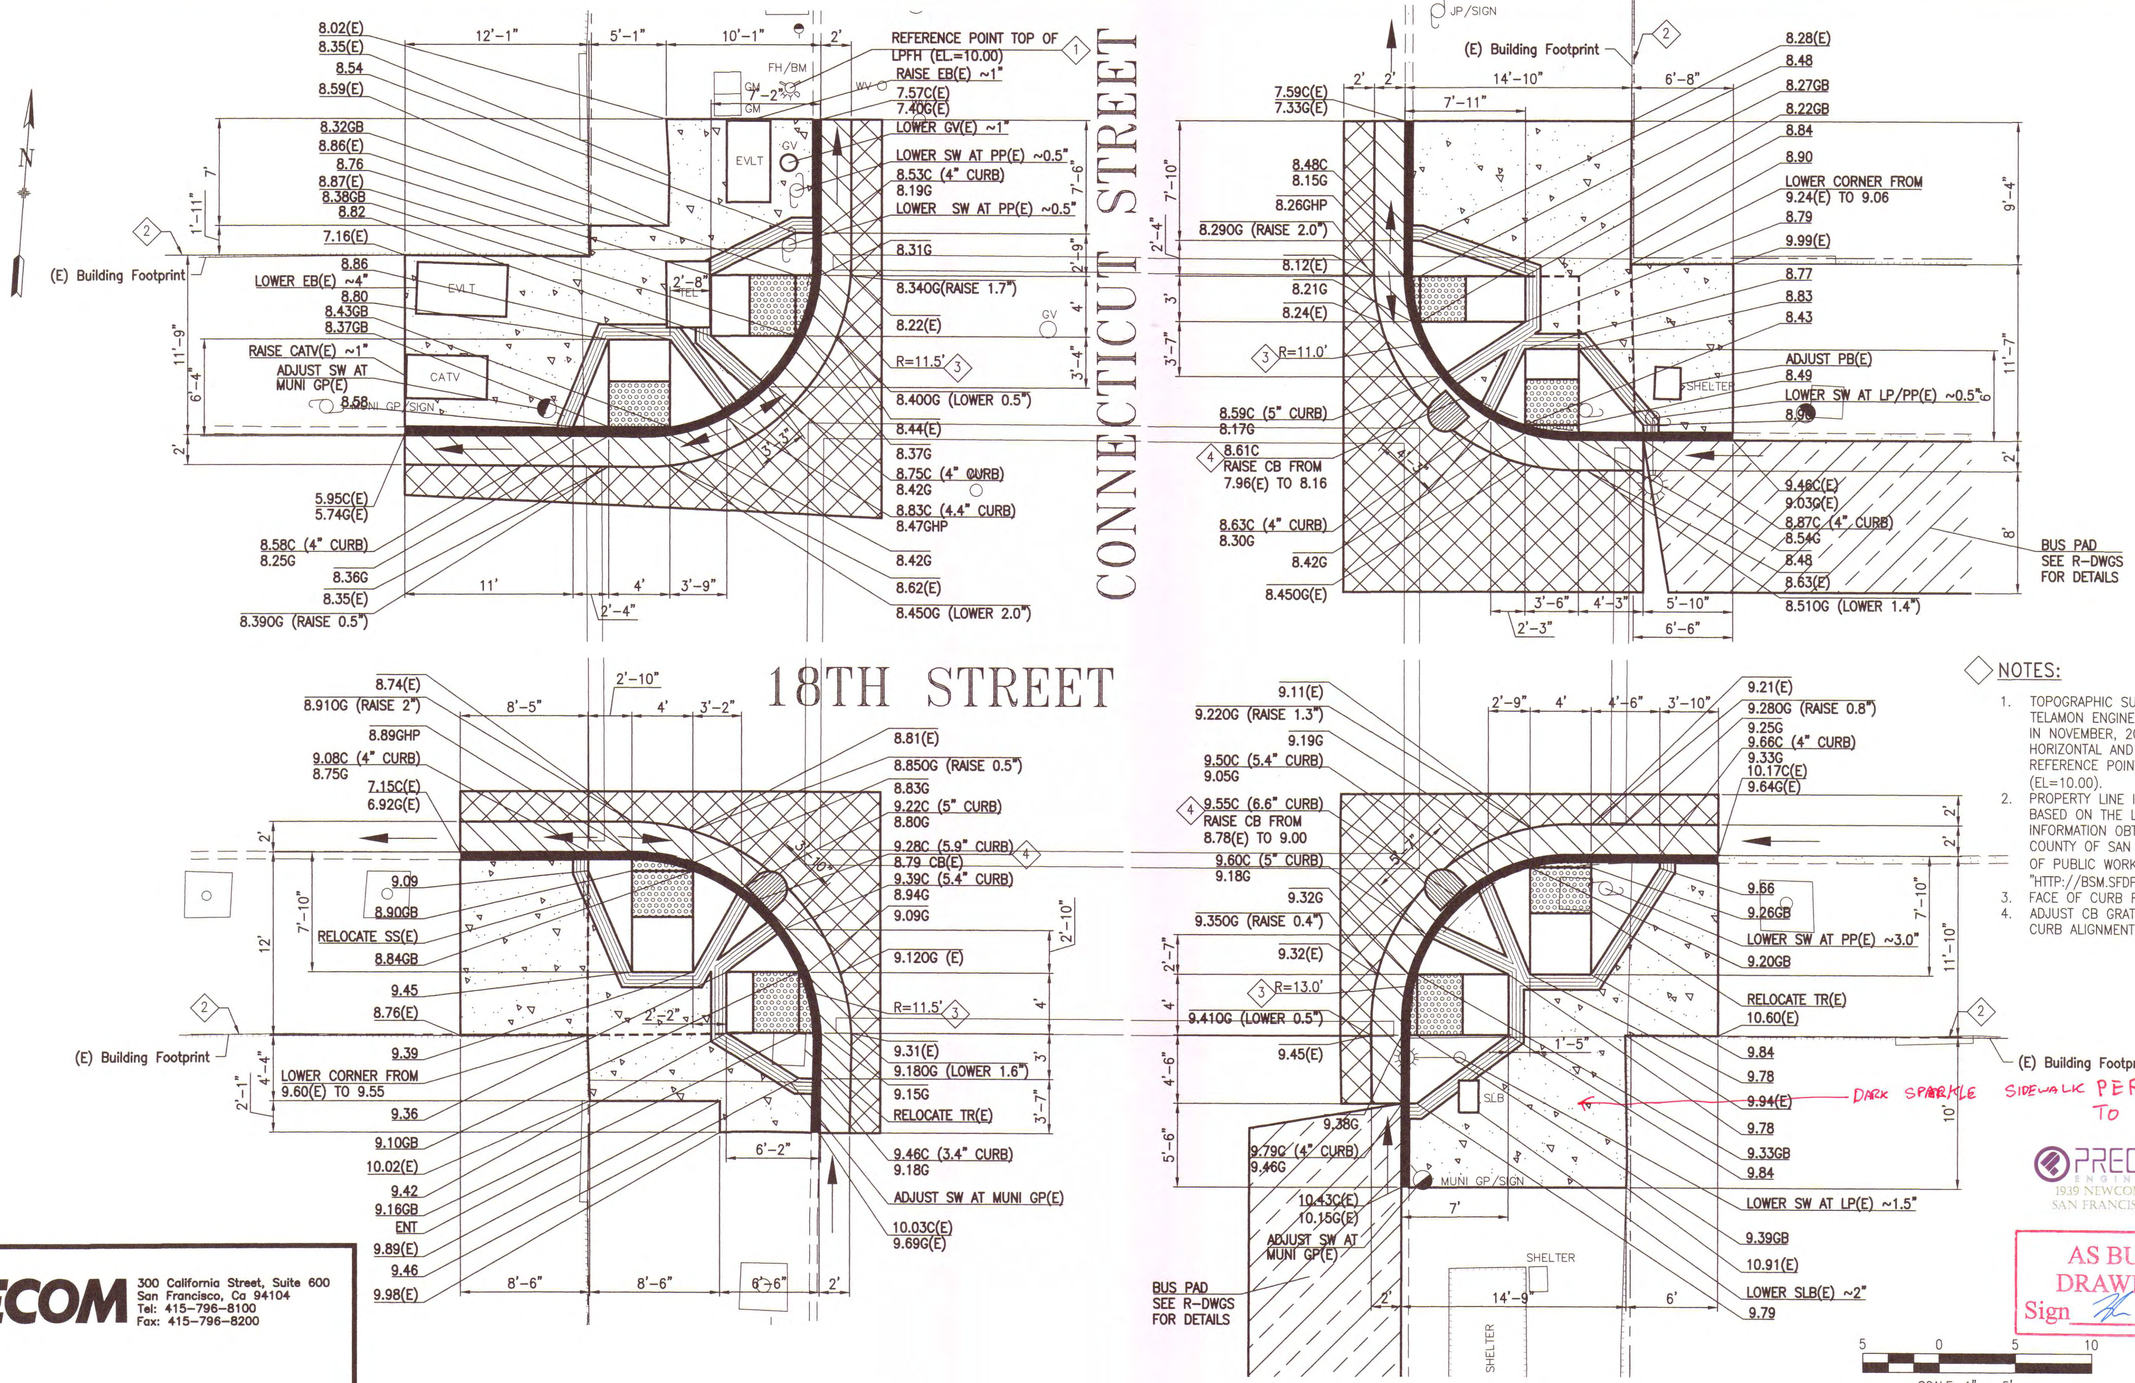

DARK SPARKLE SIDEWALK PER RESPONSE TO RFI 16.

NOTES:

1. TOPOGRAPHIC SURVEY PERFORMED BY TELAMON ENGINEERING CONSULTANTS, INC. IN NOVEMBER, 2016 USING AN ASSUMED HORIZONTAL AND VERTICAL DATUM, SEE REFERENCE POINT ON TOP OF LPFH (EL=10.00).
2. PROPERTY LINE IS APPROXIMATE AND BASED ON THE LATEST GRADE MAP INFORMATION OBTAINED FROM THE CITY & COUNTY OF SAN FRANCISCO DEPARTMENT OF PUBLIC WORKS (SFDPW) WEBSITE: "HTTP://BSM.SFDPW.ORG/SUBDIVISION/KEYMAP/."
3. FACE OF CURB RADIUS AS NOTED.
4. ADJUST CB GRATE HORIZONTALLY TO NEW CURB ALIGNMENT.

PRECISION ENGINEERING
1939 NEWCOMB AVENUE
SAN FRANCISCO, CA 94124

AECOM
300 California Street, Suite 600
San Francisco, Ca 94104
Tel: 415-796-8100
Fax: 415-796-8200

AS BUILT DRAWINGS
Sign

NO.	DATE	DESCRIPTION	BY	APP.

TABLE OF REVISIONS
THIS DRAWING WAS LAST MODIFIED: 04/25/18 18:05, BY: joseph.burg

REFERENCE INFORMATION & FILE NO. OF SURVEYS

SEAL OF THE CITY AND COUNTY OF SAN FRANCISCO

PUBLIC WORKS
DESIGN & ENGINEERING
CITY & COUNTY OF SAN FRANCISCO
SAN FRANCISCO PUBLIC WORKS
30 VAN NESS AVENUE, 5TH FLOOR
SAN FRANCISCO, CA 94102 - 6028

		Date:
Section Mgr:	Eric T. Kiehlburg	5/16/18
Deputy Division Mgr:		5/16/18
Division Mgr:	PATRICK RIVERA	5/16/18

		DATE:
DESIGNED:	J. BURG	04/18
DRAWN:	B. CARPENTER	04/18
CHECKED:	T. SWEET	04/18

REGISTERED PROFESSIONAL ENGINEER CHARLES M. SWEET C 58265 EXP. 06/30/18 CIVIL STATE OF CALIFORNIA

SCALE: 1" = 5'

SHEET OF SHEETS: 32 OF 89

VARIOUS LOCATIONS PAVEMENT RENOVATION NO. 37 AND SEWER REPLACEMENT

CONNECTICUT STREET AND 18TH STREET CURB RAMP DETAILS

EHY JO NO. 2963J
CONTRACT NO. 2792J
DRAWING NO. CR-09
FILE NO. 109,971
REV. NO.

Xrefs: T:\SFDPW Various Locations 37 (2792J)\Plan\XC-2792J-BOE Title Block.dwg
T:\SFDPW Various Locations 37 (2792J)\Plan\XC-TOPO CONNECTICUT AND 18TH.dwg
T:\SFDPW Various Locations 37 (2792J)\Plan\XC-DESIGN CONNECTICUT AND 18TH_BUS PAD EDITS.dwg

Dimension Scale: 5
Model Units: Undefined

Drawing Path: T:\SFDPW Various Locations 37 (2792J)\Sheet\CR-09.dwg, Login: joseph.burg
Plot Time: Thu, 26 Apr 2018 - 7:52am
Measurement Units are English