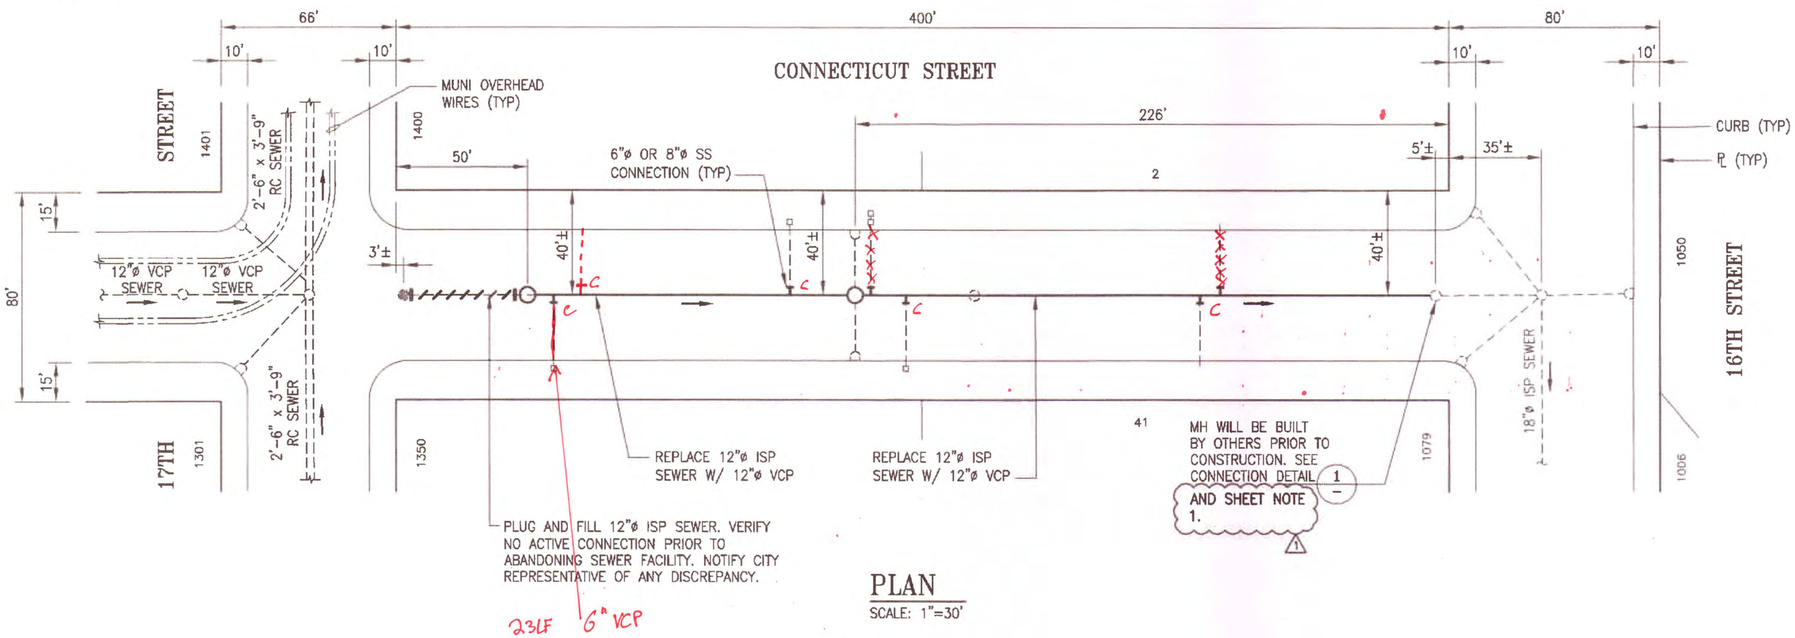

PLAN

SCALE: 1"=30'

SHEET NOTES:

1. MANHOLE TO BE CONSTRUCTED UNDER SFMTA CONTRACT 1303. SEE SPEC 01 11 00 FOR COORDINATION.

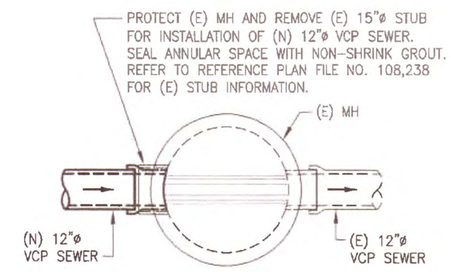

MH CONNECTION DETAIL 1

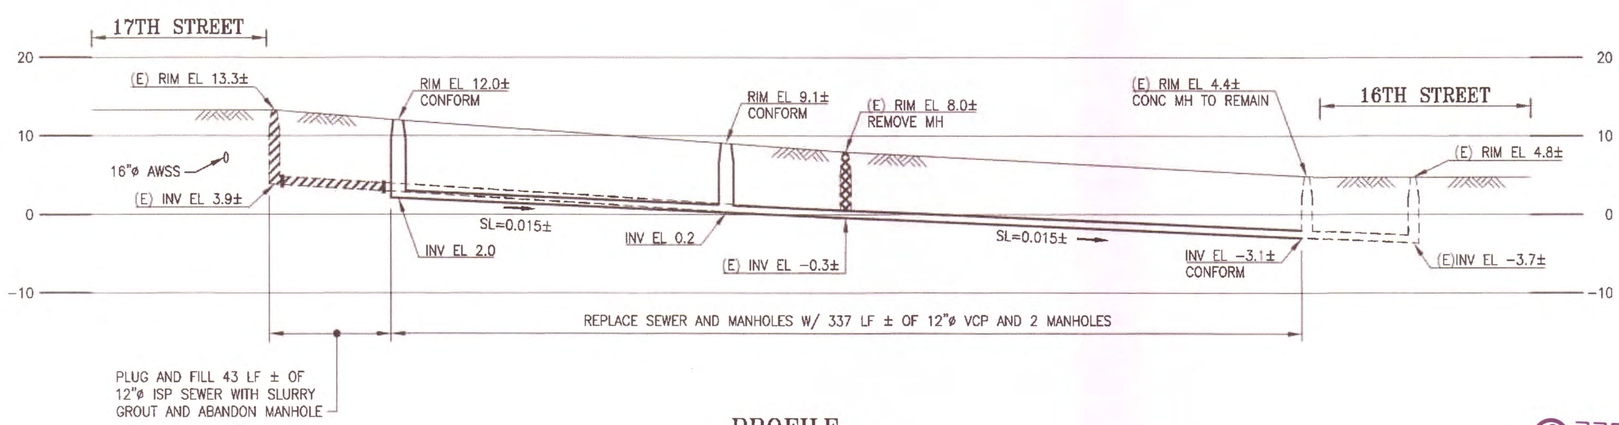

PROFILE

SCALE: HORIZ 1"=30'
VERT 1"=10'

PRECISION ENGINEERING
1939 NEWCOMB AVENUE
SAN FRANCISCO, CA 94124

AS BUILT DRAWINGS
Sign

30' 0 30' 60' HORIZONTAL SCALE: 1"=30'

10' 0 10' 20' VERTICAL SCALE: 1"=10'

SEWER SIZED BY Y.W.

APPROVED BY B.S.

SEE REV. 0 FOR ORIGINAL SIGNATURES

NO.	DATE	DESCRIPTION	BY	APP.
1	7/18	CLARIFY WORK SCOPE	JK	JH

TABLE OF REVISIONS

REFERENCE INFORMATION & FILE NO. OF SURVEYS
SH-16-54
P3-594
P3-631
86991
108238

SEAL OF THE CITY AND COUNTY OF SAN FRANCISCO

SAN FRANCISCO PUBLIC WORKS
DESIGN & ENGINEERING
CITY & COUNTY OF SAN FRANCISCO
SAN FRANCISCO PUBLIC WORKS
30 VAN NESS AVENUE, 5TH FLOOR
SAN FRANCISCO, CA 94102 - 6028

		Date:
Section Mgr:	LESLEY WONG	
Deputy Bureau Mgr:	IQBAL DHAPA	
Bureau Mgr:	PATRICK RIVERA	

DESIGNED:	J.KUNG JK	DATE: 7/2018
DRAWN:	S.HUEY	DATE: 7/2018
CHECKED:	J.HELMUTH	DATE: 7/2018

REGISTERED PROFESSIONAL ENGINEER JOHN J. HELMUTH No. C69542 CIVIL STATE OF CALIFORNIA 9/19/18

SCALE: AS NOTED

SHEET OF SHEETS

VARIOUS LOCATIONS PAVEMENT RENOVATION NO. 37 AND SEWER REPLACEMENT

CONNECTICUT STREET SEWER REPLACEMENT
17TH STREET TO 16TH STREET
PLAN, PROFILE AND DETAIL

CONTRACT NO. 2792J
DRAWING NO. SW-4
FILE NO. 109,992
REV. NO. 1

HYD JOB ORDER NUMBER: 2963J