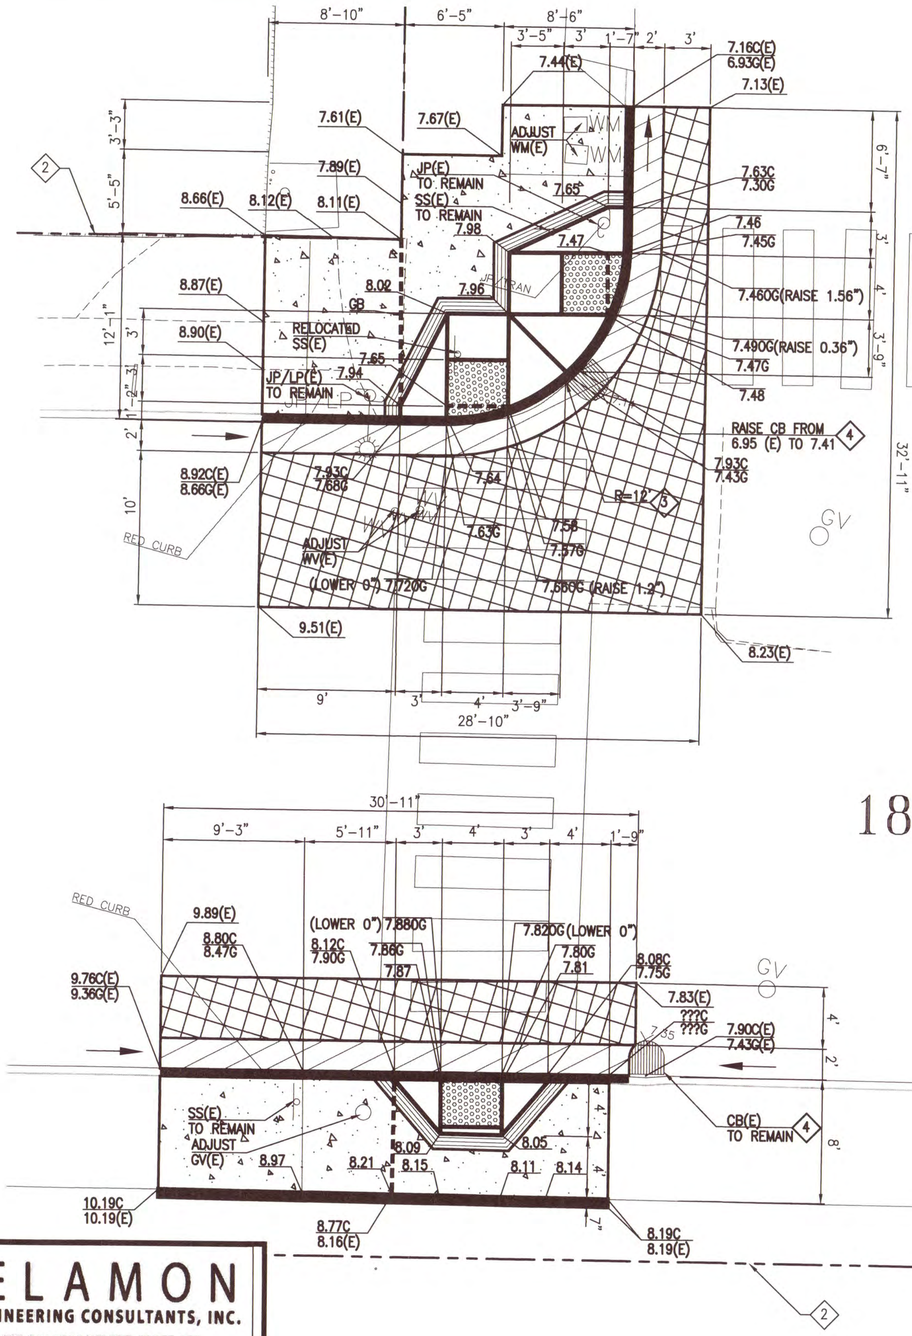

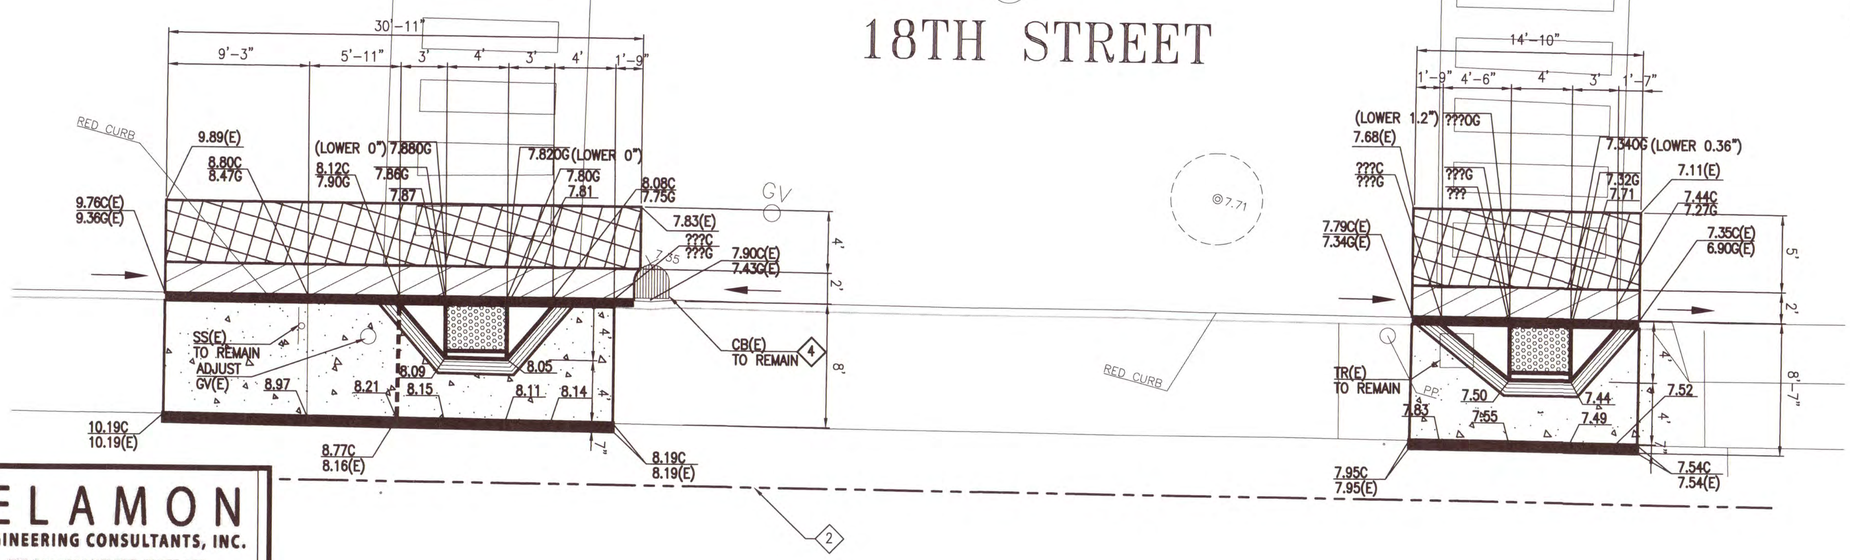

NOTES:

1. TOPOGRAPHIC SURVEY PERFORMED BY TELAMON ENGINEERING CONSULTANTS, INC. IN MAY 2016 USING AN ASSUMED HORIZONTAL AND VERTICAL DATUM, SEE REFERENCE POINT ON TOP OF LPFH (EL=10.00).
2. PROPERTY LINE IS APPROXIMATE AND BASED ON THE LATEST GRADE MAP INFORMATION OBTAINED FROM THE CITY & COUNTY OF SAN FRANCISCO DEPARTMENT OF PUBLIC WORKS (SFDPW) WEBSITE:"HTTP://BSM.SFDPW.ORG/SUBDIVISION/KEYMAP/"
3. FACE OF CURB RADIUS AS NOTED.
4. ADJUST CATCH BASIN AND GRATE TO NEW CURB ALIGNMENT.
5. CONTACT BUREAU OF STREET USE AND MAPPING TO COORDINATE MODIFICATION OF MONUMENT PRIOR TO CONSTRUCTION.
6. CONSTRUCT DRIVEWAY PER CITY OF SAN FRANCISCO STANDARD PLAN FILE NO. 88,171.

N

5 0 5 10

SCALE: 1" = 5'

PRECISION ENGINEERING
1939 NEWCOMB AVENUE
SAN FRANCISCO, CA 94124

AS BUILT DRAWINGS
Sign

TELAMON
ENGINEERING CONSULTANTS, INC.
855 FOLSOM STREET, SUITE 142
SAN FRANCISCO, CA 94107
TEL: 415-837-1336 FAX: 415-837-1354

NO.	DATE	DESCRIPTION	BY	APP.

TABLE OF REVISIONS
THIS DRAWING WAS LAST MODIFIED: 04/25/18 11:18, BY: Doug

REFERENCE INFORMATION & FILE NO. OF SURVEYS

SEAL OF THE CITY AND COUNTY OF SAN FRANCISCO

PUBLIC WORKS
DESIGN & ENGINEERING
CITY & COUNTY OF SAN FRANCISCO
SAN FRANCISCO PUBLIC WORKS
30 VAN NESS AVENUE, 5TH FLOOR
SAN FRANCISCO, CA 94102 - 6028

		Date:
Section Mgr:	Eric T. Kellberg	5/16/18
Deputy Division Mgr:	FERNANDO CISNEROS	5/16/18
Division Mgr:	PATRICK RIVERA	5/16/18

DESIGNED:	DATE:
DZ	04/18
DRAWN:	DATE:
KN	04/18
CHECKED:	DATE:
MC	04/18

REGISTERED PROFESSIONAL ENGINEER
MINOR CHAN
No. C043842
Exp 6-30-19
CIVIL
STATE OF CALIFORNIA

SCALE: 1" = 5'

SHEET OF SHEETS: 38 OF 89

VARIOUS LOCATIONS PAVEMENT RENOVATION NO. 37 AND SEWER REPLACEMENT

18TH ST AND CAROLINA ST CURB RAMP DETAILS

EHY JO NO. 2963J
CONTRACT NO. 2792J
DRAWING NO. CR-15
FILE NO. 109,977
REV. NO.

Xrefs: P:\16071_2792J CRD VL#37\3_Dwg\Xrefs\XC-SLOPE-FIG.dwg
P:\16071_2792J CRD VL#37\3_Dwg\Xrefs\X-NOTE-DSSC.dwg
P:\16071_2792J CRD VL#37\3_Dwg\Xrefs\18TH AND CAROLINA.dwg

Dimension Scale: 5
Model Units: Feet

Drawing Path: P:\16071_2792J CRD VL#37\3_Dwg\CR15 - 18TH St And Carolina St.dwg, Login: Doug
Plot Time: Wed, 25 Apr 2018 - 11:18am
Measurement Units are English