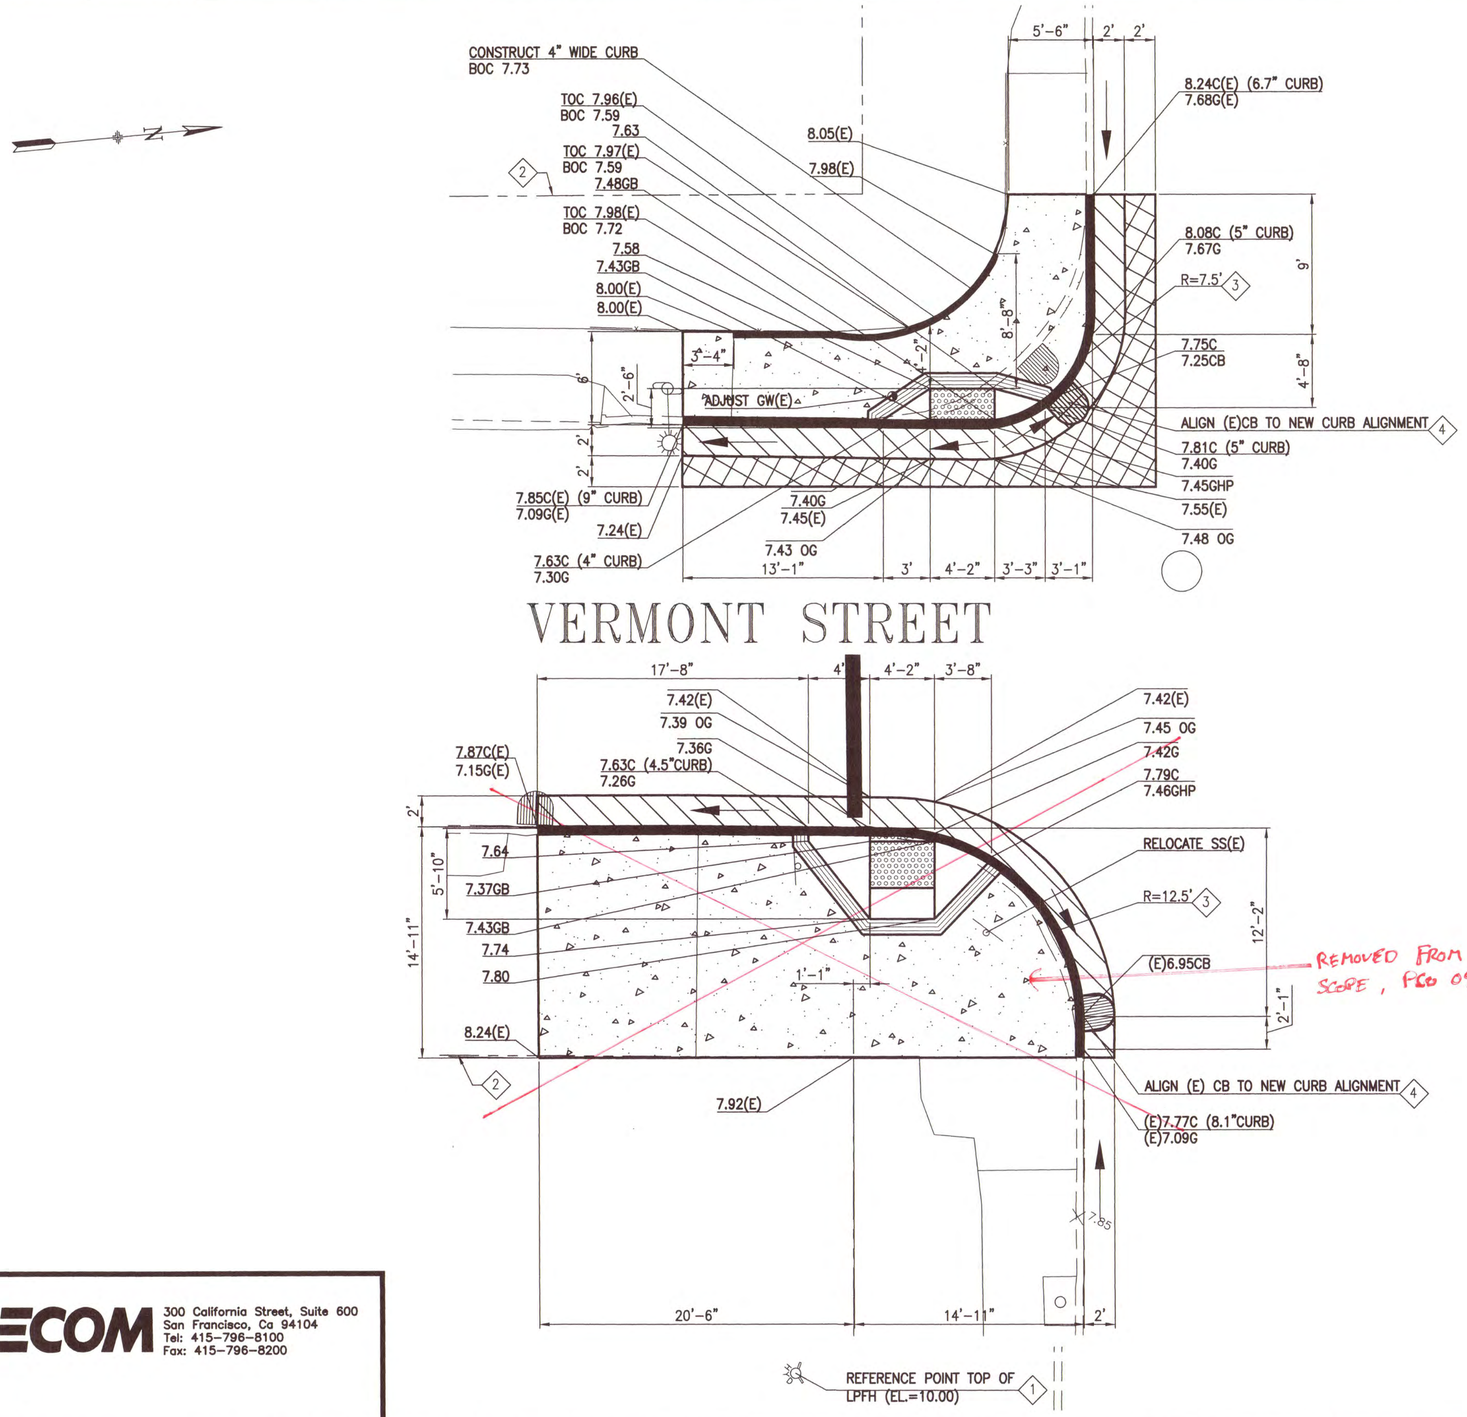

SLB

NOTES:

1. TOPOGRAPHIC SURVEY PERFORMED BY TELAMON ENGINEERING CONSULTANTS, INC. IN OCTOBER, 2017 USING AN ASSUMED HORIZONTAL AND VERTICAL DATUM, SEE REFERENCE POINT ON TOP OF LPFH (EL=10.00) AT THE SOUTHWESTERN CORNER OF THE INTERSECTION OF DIVISION STREET AND HENRY ADAMS STREET.
2. PROPERTY LINE IS APPROXIMATE AND BASED ON THE LATEST GRADE MAP INFORMATION OBTAINED FROM THE CITY & COUNTY OF SAN FRANCISCO DEPARTMENT OF PUBLIC WORKS (SFDPW) WEBSITE: "HTTP://BSM.SFDPW.ORG/SUBDIVISION/KEYMAP/."
3. FACE OF CURB RADIUS AS NOTED.
4. ADJUST CB GRATE HORIZONTALLY TO NEW CURB ALIGNMENT.

PRECISION ENGINEERING
1939 NEWCOMB AVENUE
SAN FRANCISCO, CA 94124

AS BUILT DRAWINGS
Sign

5 0 5 10
SCALE: 1" = 5'

AECOM
300 California Street, Suite 600
San Francisco, Ca 94104
Tel: 415-796-8100
Fax: 415-796-8200

NO.	DATE	DESCRIPTION	BY	APP.

TABLE OF REVISIONS
THIS DRAWING WAS LAST MODIFIED: 04/23/18 18:25, BY: joseph.burg

REFERENCE INFORMATION & FILE NO. OF SURVEYS

SEAL OF THE CITY AND COUNTY OF SAN FRANCISCO

SAN FRANCISCO PUBLIC WORKS
DESIGN & ENGINEERING
CITY & COUNTY OF SAN FRANCISCO
SAN FRANCISCO PUBLIC WORKS
30 VAN NESS AVENUE, 5TH FLOOR
SAN FRANCISCO, CA 94102 - 6028

		Date:
Section Mgr:	Eric T. Kilburg	5/16/18
Deputy Division Mgr:		5/16/18
Division Mgr:	PATRICK RIVERA	5/16/18

DESIGNED:	A. EHSAEI	DATE: 04/18
DRAWN:	B. CARPENTER	DATE: 04/18
CHECKED:	T. SWEETKNS	DATE: 04/18

REGISTERED PROFESSIONAL ENGINEER
THOMAS M. SWEET
No. C 68265
EXP. 06/30/18
CIVIL
STATE OF CALIFORNIA

SCALE: 1" = 5'
SHEET OF SHEETS: 36 OF 89

VARIOUS LOCATIONS PAVEMENT RENOVATION NO. 37 AND SEWER REPLACEMENT

VERMONT STREET AND DIVISION STREET CURB RAMP DETAILS

EHY JO NO. 2963J
CONTRACT NO. 2792J
DRAWING NO. CR-13
FILE NO. 109,975
REV. NO.

Xrefs: T:\SFDPW Various Locations 37 (2792J)\Plan\XC-2792J-BOE Title Block.dwg
T:\SFDPW Various Locations 37 (2792J)\Plan\XC-TOPO DIVISION AND VERMONT.dwg
T:\SFDPW Various Locations 37 (2792J)\Plan\Redesign Vermont and Division\XC-DESIGN DIVISION AND VERMONT-RECOMMENDATIONS F

Dimension Scale: 5
Model Units: Undefined

Drawing Path: T:\SFDPW Various Locations 37 (2792J)\Sheet\CR-13.dwg, Login: joseph.burg
Plot Time: Mon, 23 Apr 2018 - 7:11pm
Measurement Units are English