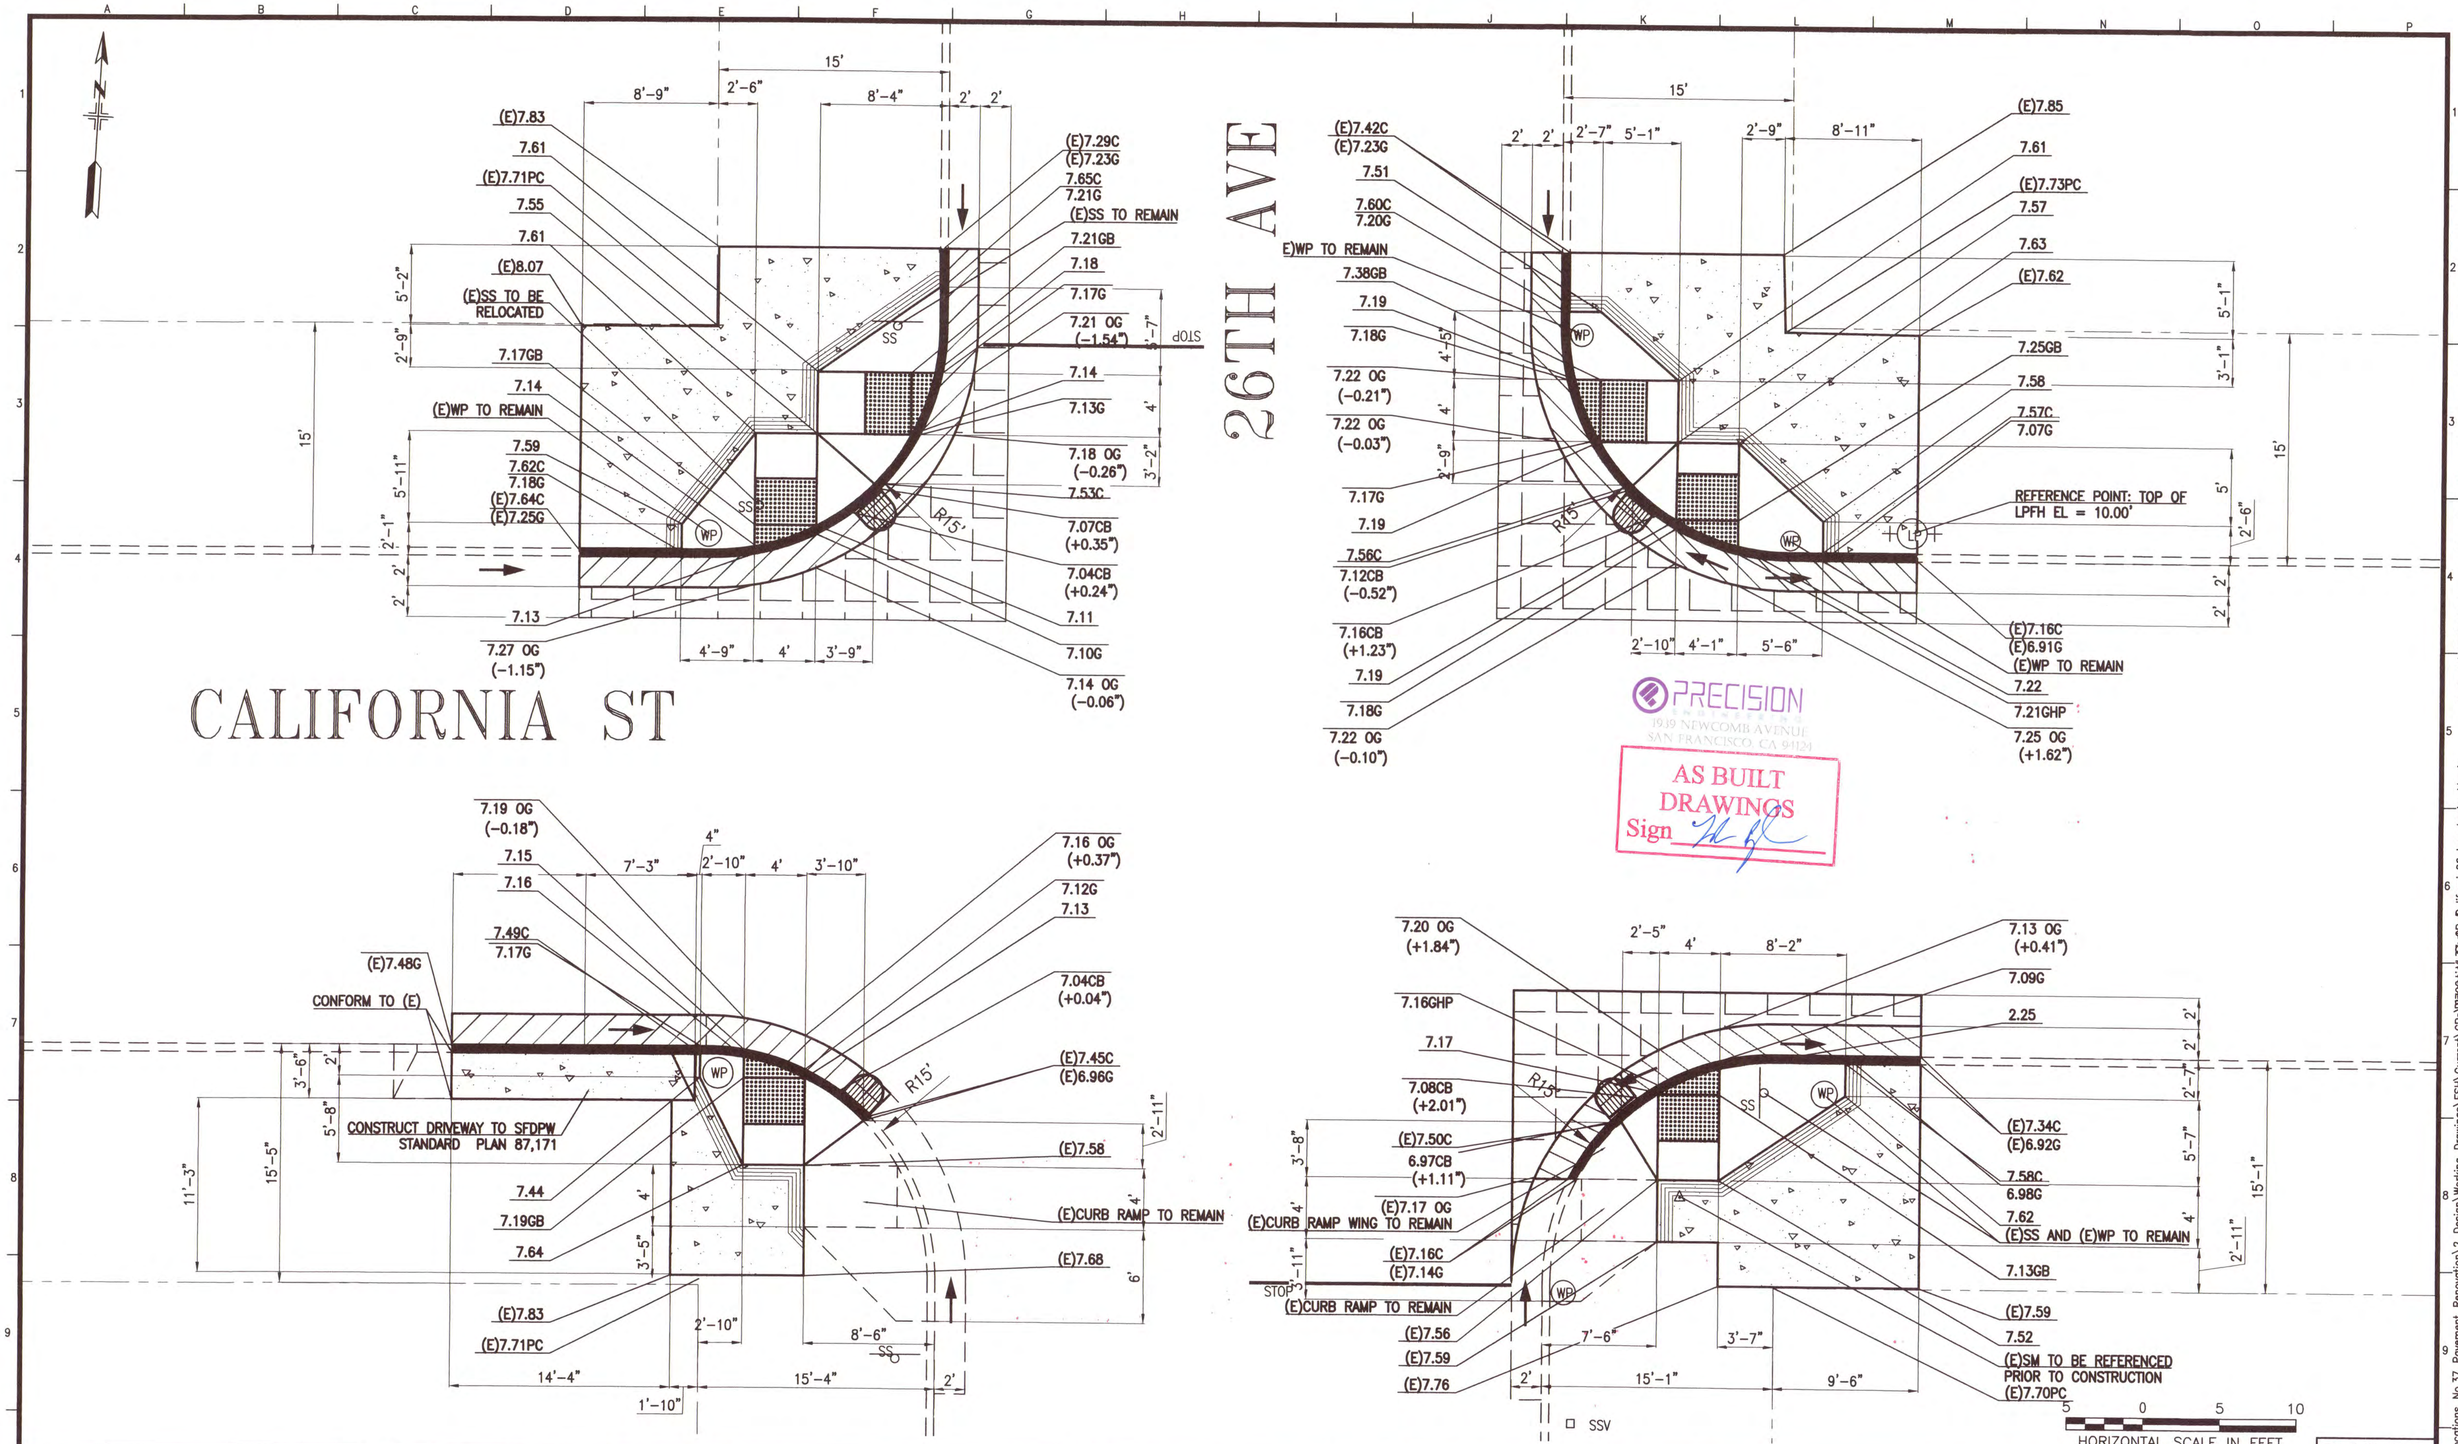

PRECISION
1939 NEWCOMB AVENUE
SAN FRANCISCO, CA 94124

AS BUILT DRAWINGS
Sign

NO.	DATE	DESCRIPTION	BY	APP.

TABLE OF REVISIONS
THIS DRAWING WAS LAST MODIFIED: 04/26/18 17:30, BY: LLouie

REFERENCE INFORMATION & FILE NO. OF SURVEYS

SEAL OF THE CITY AND COUNTY OF SAN FRANCISCO

PUBLIC WORKS

DESIGN & ENGINEERING
CITY & COUNTY OF SAN FRANCISCO
SAN FRANCISCO PUBLIC WORKS
30 VAN NESS AVENUE, 5TH FLOOR
SAN FRANCISCO, CA 94102 - 6028

		Date:
Section Mgr:	Eric T. Kirkbag	5/16/18
Deputy Division Mgr:		5/16/18
Division Mgr:		5/16/18

		DATE:
DESIGNED:	L.LOUIE	03/18
DRAWN:	L.LOUIE	03/18
CHECKED:	D.CALLEROS	04/18

REGISTERED PROFESSIONAL ENGINEER DEANNA M. CALLEROS No. C59417 CIVIL STATE OF CALIFORNIA 5/15/18

SCALE: 1" = 5'

SHEET OF SHEETS: 42 OF 89

VARIOUS LOCATIONS PAVEMENT RENOVATION NO. 37 AND SEWER REPLACEMENT

CALIFORNIA STREET AND 26TH AVE CURB RAMP DETAILS

EHY JO NO. 2963J

CONTRACT NO. 2792J

DRAWING NO. CR-18

FILE NO. 109,980

REV. NO.

Xrefs: V:\2792J_Various_Locations_No.37_Pavement_Renovation\Official_Project_TB\DEI_TB_22x34.dwg
Q:\CADS 2000\Discipline\Streets & Highways\Blocks\RevisionTitleBlock.dwg

Drawing Path: V:\2792J_Various_Locations_No.37_Pavement_Renovation\2_Design\Working_Drawings\ESH\Current\CRs\CR-18\California26.dwg, Login: LLouie
Plot Time: Tue, 15 May 2018 - 1:28pm
Model Units: Feet
Measurement Units are English